

084 W 12 R C 01000


1" = 1320'

Tax Lot: 1000



T8S, R4W

T8S, R3W

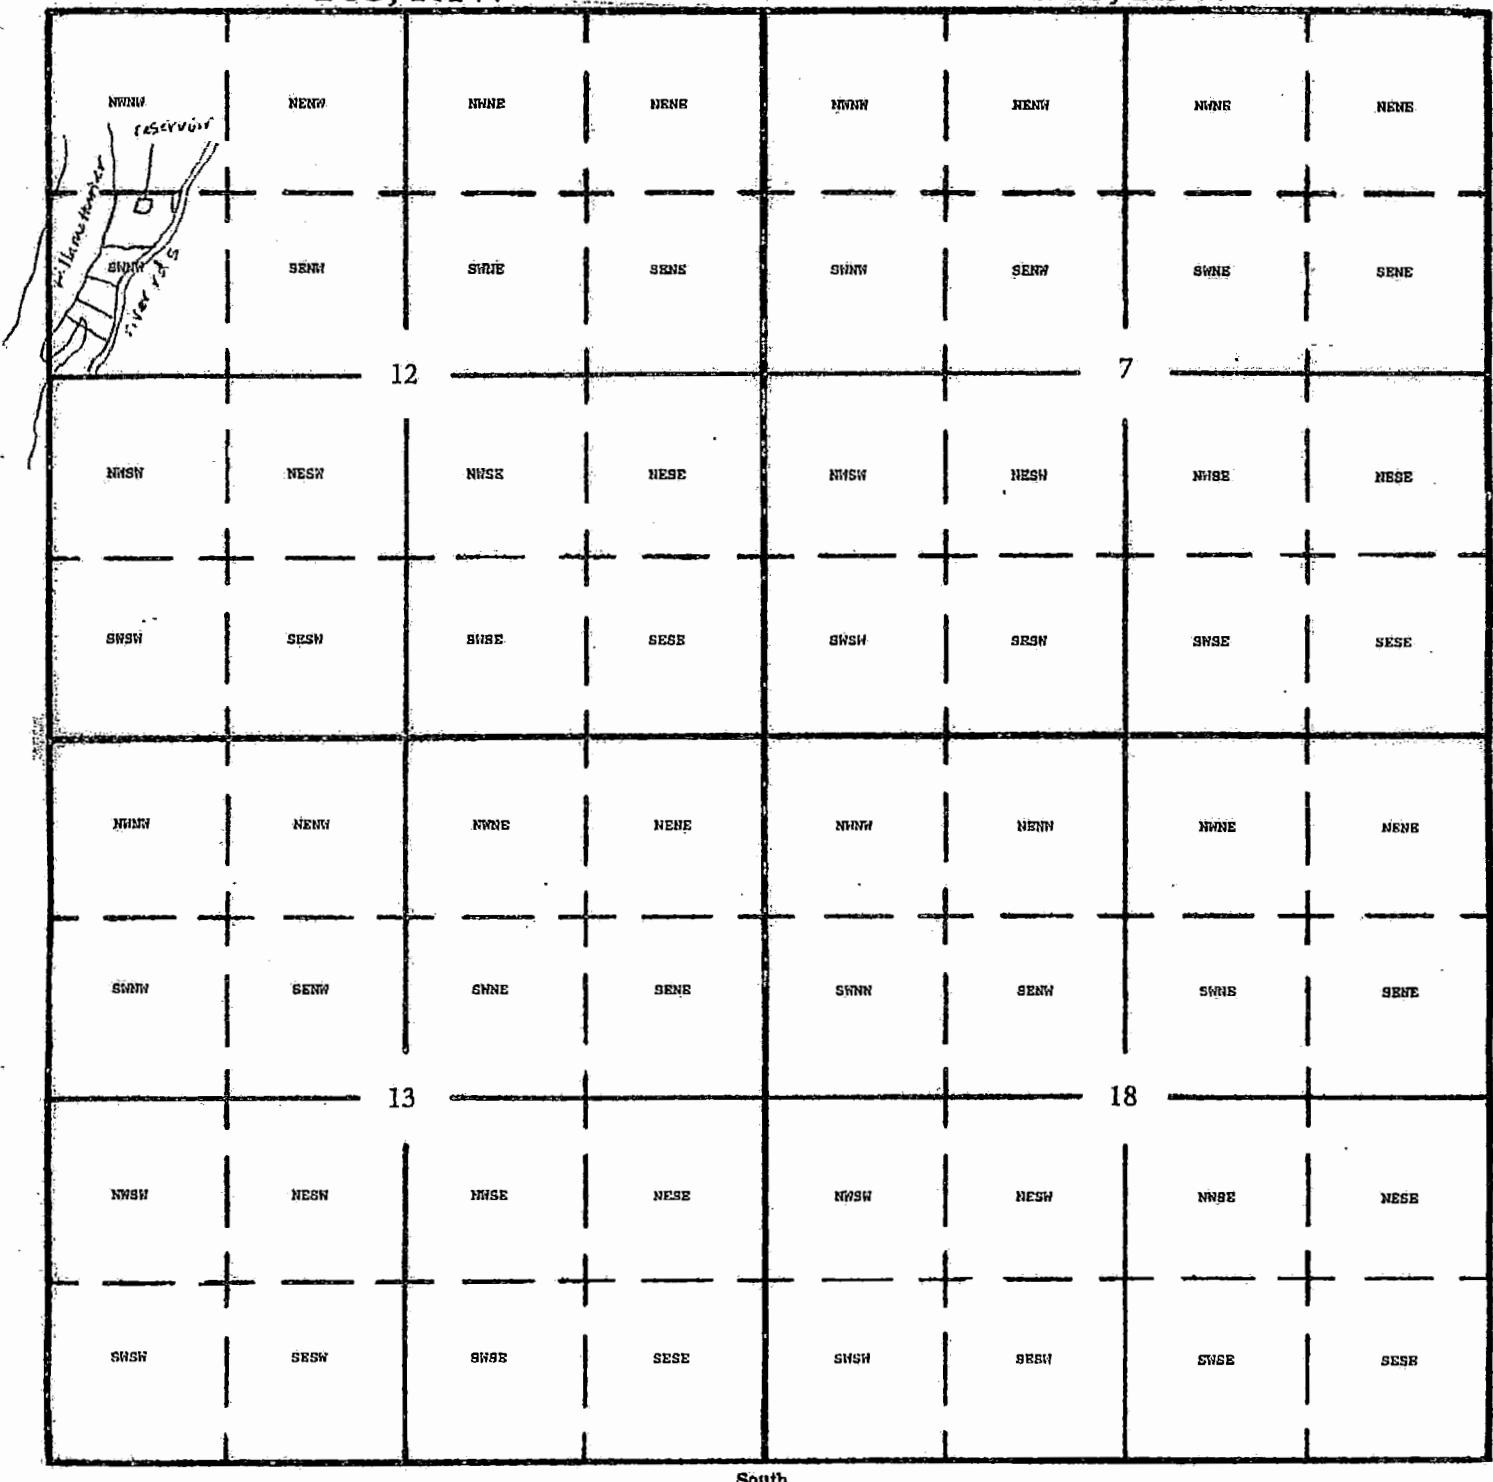

Center of reservoir: 115 ft south & 665 ft east from NW corner, SWNW, Sec 12

RECEIVED

MAY 29 2018

OWRD

R-88494

RECEIVED

JAN 08 2018

OWRD

RECEIVED BY OWRD

DEC 08 2017

SALEM, OR