


Polk County Map

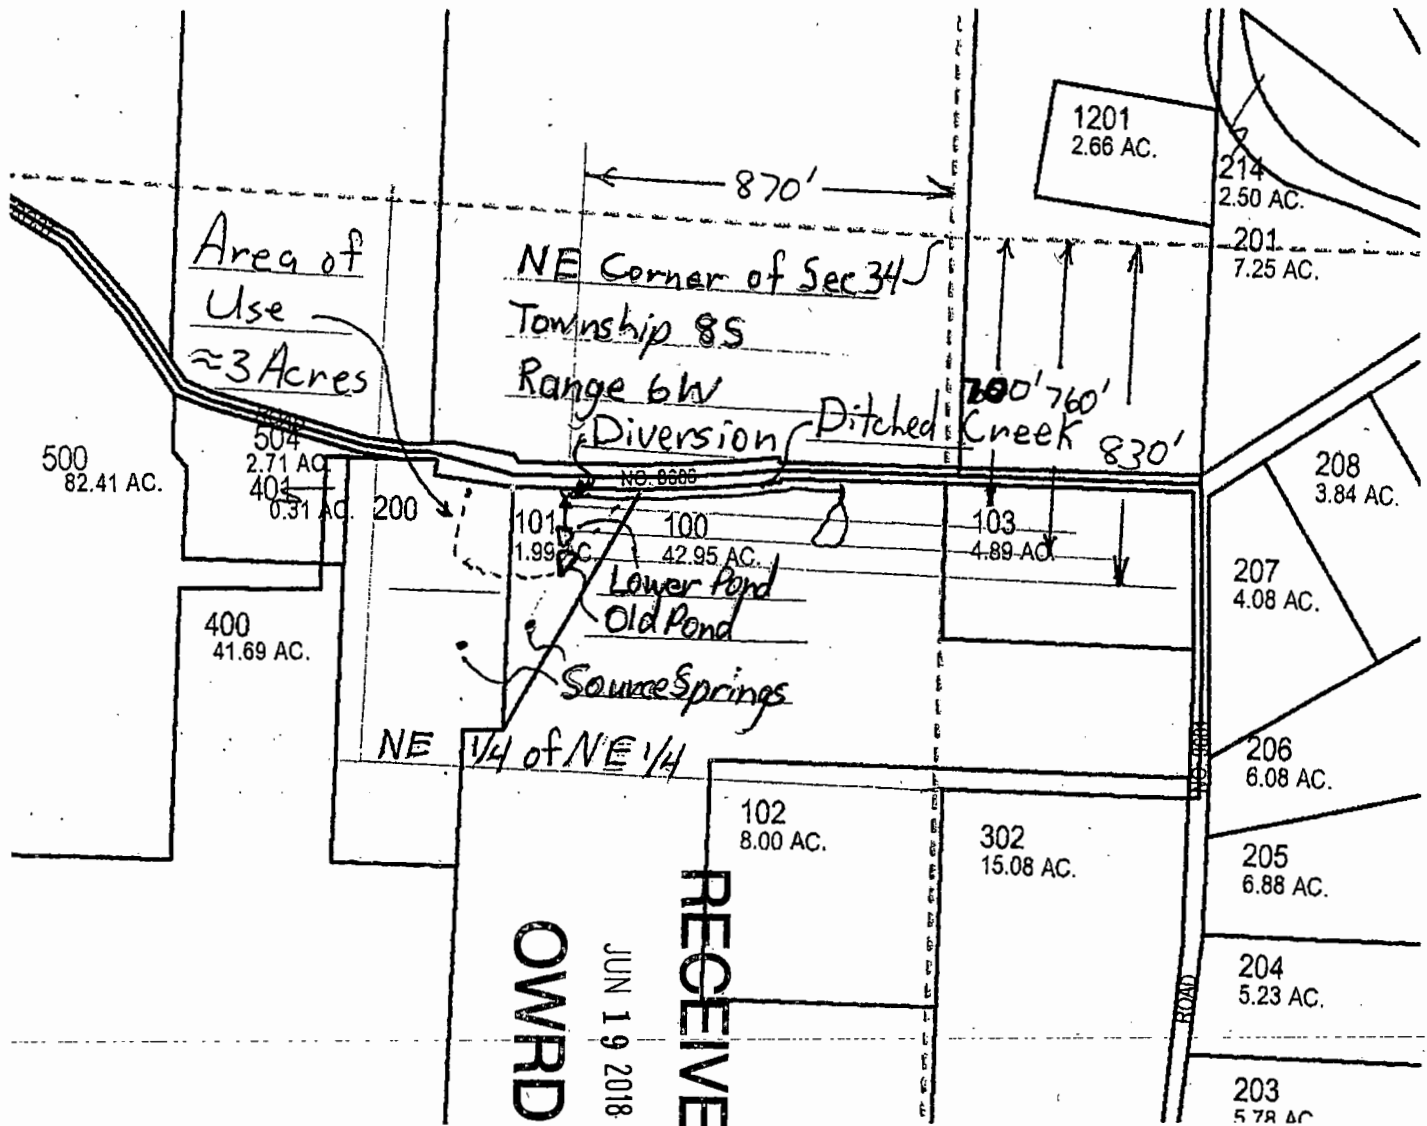


Community Development

- Roads
 - OTHER
 - CO-GRAVL
 - STATEHWY
 - CO-PAVED
- Section
 - 1
 - 5
- Taxlot
 - Taxlot Arrows
 - Taxlot Boundary

*The Dams form
the North Edge
of Both Ponds*

RECEIVED

JUL 30 2004
WATER RESOURCES DEPT
SALEM, OREGON

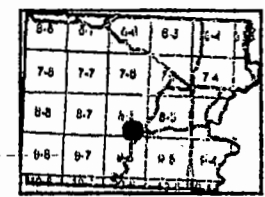

4/14/2004

RECEIVED
 JUN 19 2018
OWPRD

This map was produced using the Polk County GIS data. The GIS data is maintained by the county to support its governmental activities. The county is not responsible for map errors, omissions, misuse or misinterpretation.

APP NO. R86058