


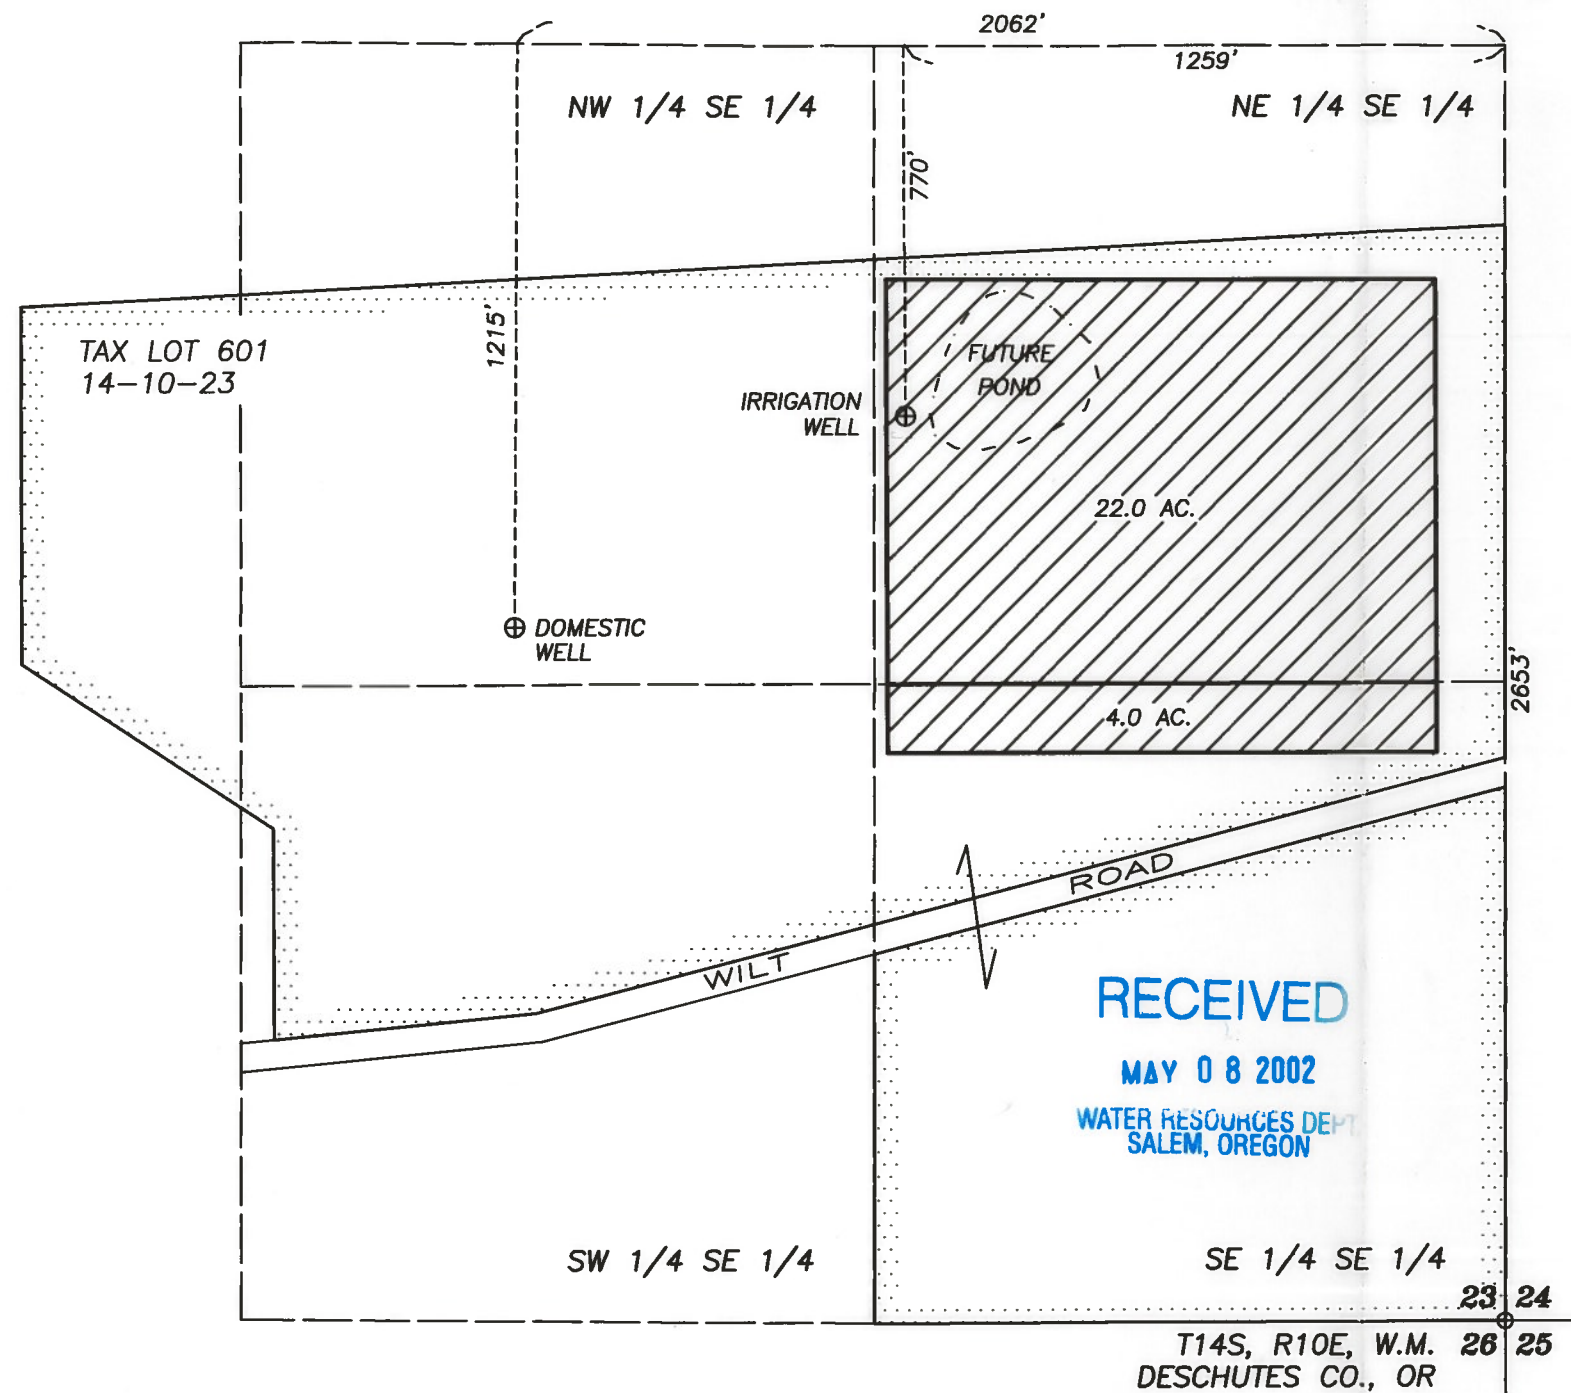

FINAL PROOF SURVEY

CLAIM OF BENEFICIAL USE


APPLICATION NO. G-14633

PERMIT NO. G-13442

IN THE NAME OF BRUCE SLAYDEN



IRRIGATED AREA

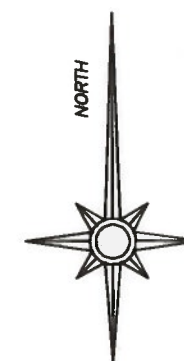

RECEIVED

MAY 08 2002

WATER RESOURCES DEPT
SALEM, OREGON



THIS MAP IS FOR THE PURPOSE OF IDENTIFYING THE LOCATION OF THE WATER RIGHT.
IT IS NOT INTENDED TO PROVIDE LEGAL DIMENSIONS OR LOCATIONS OF PROPERTY
OWNERSHIP LINES.

Fred A. Ast, Jr. and Associates

250 W. Cascade Avenue

P.O. Box 751

Sisters, Oregon 97759

541-549-7851