

CLAIM OF BENEFICIAL USE MAP

DEER ISLAND STOCK RANCH TRUST

TAX LOT 100

LOCATED IN THE NE 1/4 SE 1/4 AND NW 1/4 SE 1/4 OF
SECTION 8 T.5N., R.1W., W.M.
COLUMBIA COUNTY, OREGON



MUCKLE RESERVOIR
APPLICATION NO. 84445

NOTE: THE METER FOR THIS PERMIT IS LOCATED
N78°37'09"E A DISTANCE OF 4786' FROM THE SW
CORNER OF SECTION 17, T.5N., R.1W., W.M. AT THE
DYNO NOBEL CHEMICAL PLANT.

DITCH TO ADAMS

STREAM OUTLET

CENTER OF SECTION
8, T.5N., R.1W., W.M.

RECEIVED

MAR 11 2020


OWRD

POINT OF DIVERSION
N27°05'05"E, 7796'
FROM SW CORNER OF SECTION 17
T.5N., R.1W., W.M.

NOTE: THE PREPARATION OF THIS MAP WAS FOR THE
PURPOSE OF IDENTIFYING THE LOCATION OF THE
WATER RIGHT AND HAS NO INTENT TO PROVIDE
DIMENSIONS OR LOCATIONS OF PROPERTY
OWNERSHIP LINES.

DITCH FROM COOLING POND

LOCATED IN
NW 1/4 SE 1/4
SE 1/4 SW 1/4
TOWNSHIP 5 NORTH, RANGE 1 WEST, W.M.

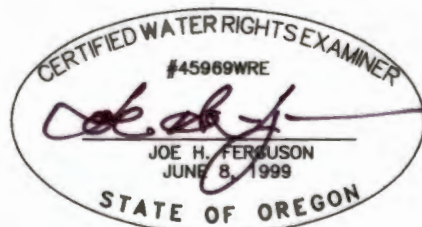

RENEWAL DATE 12/31/21

CLIENT:

DEER ISLAND STOCK RANCH TRUST
65640 DEER ISLAND RD
DEER ISLAND, OREGON

Ferguson Land Surveying, Inc.

646 SE 106TH AVE. PORTLAND, OR 97216
Phone (503) 408-0601 Fax (503) 408-0602

SHEET NO. 1 OF 1

JOB NO. 15-197CBU MR

DRAFTED 3.10.2020