

CLAIM OF BENEFICIAL USE MAP

DEER ISLAND STOCK RANCH TRUST


TAX LOT 100

LOCATED IN SECTIONS 5 AND 8 T.5N., R.1W., W.M.

COLUMBIA COUNTY, OREGON

ADAMS RESERVOIR

APPLICATION NO. 84446

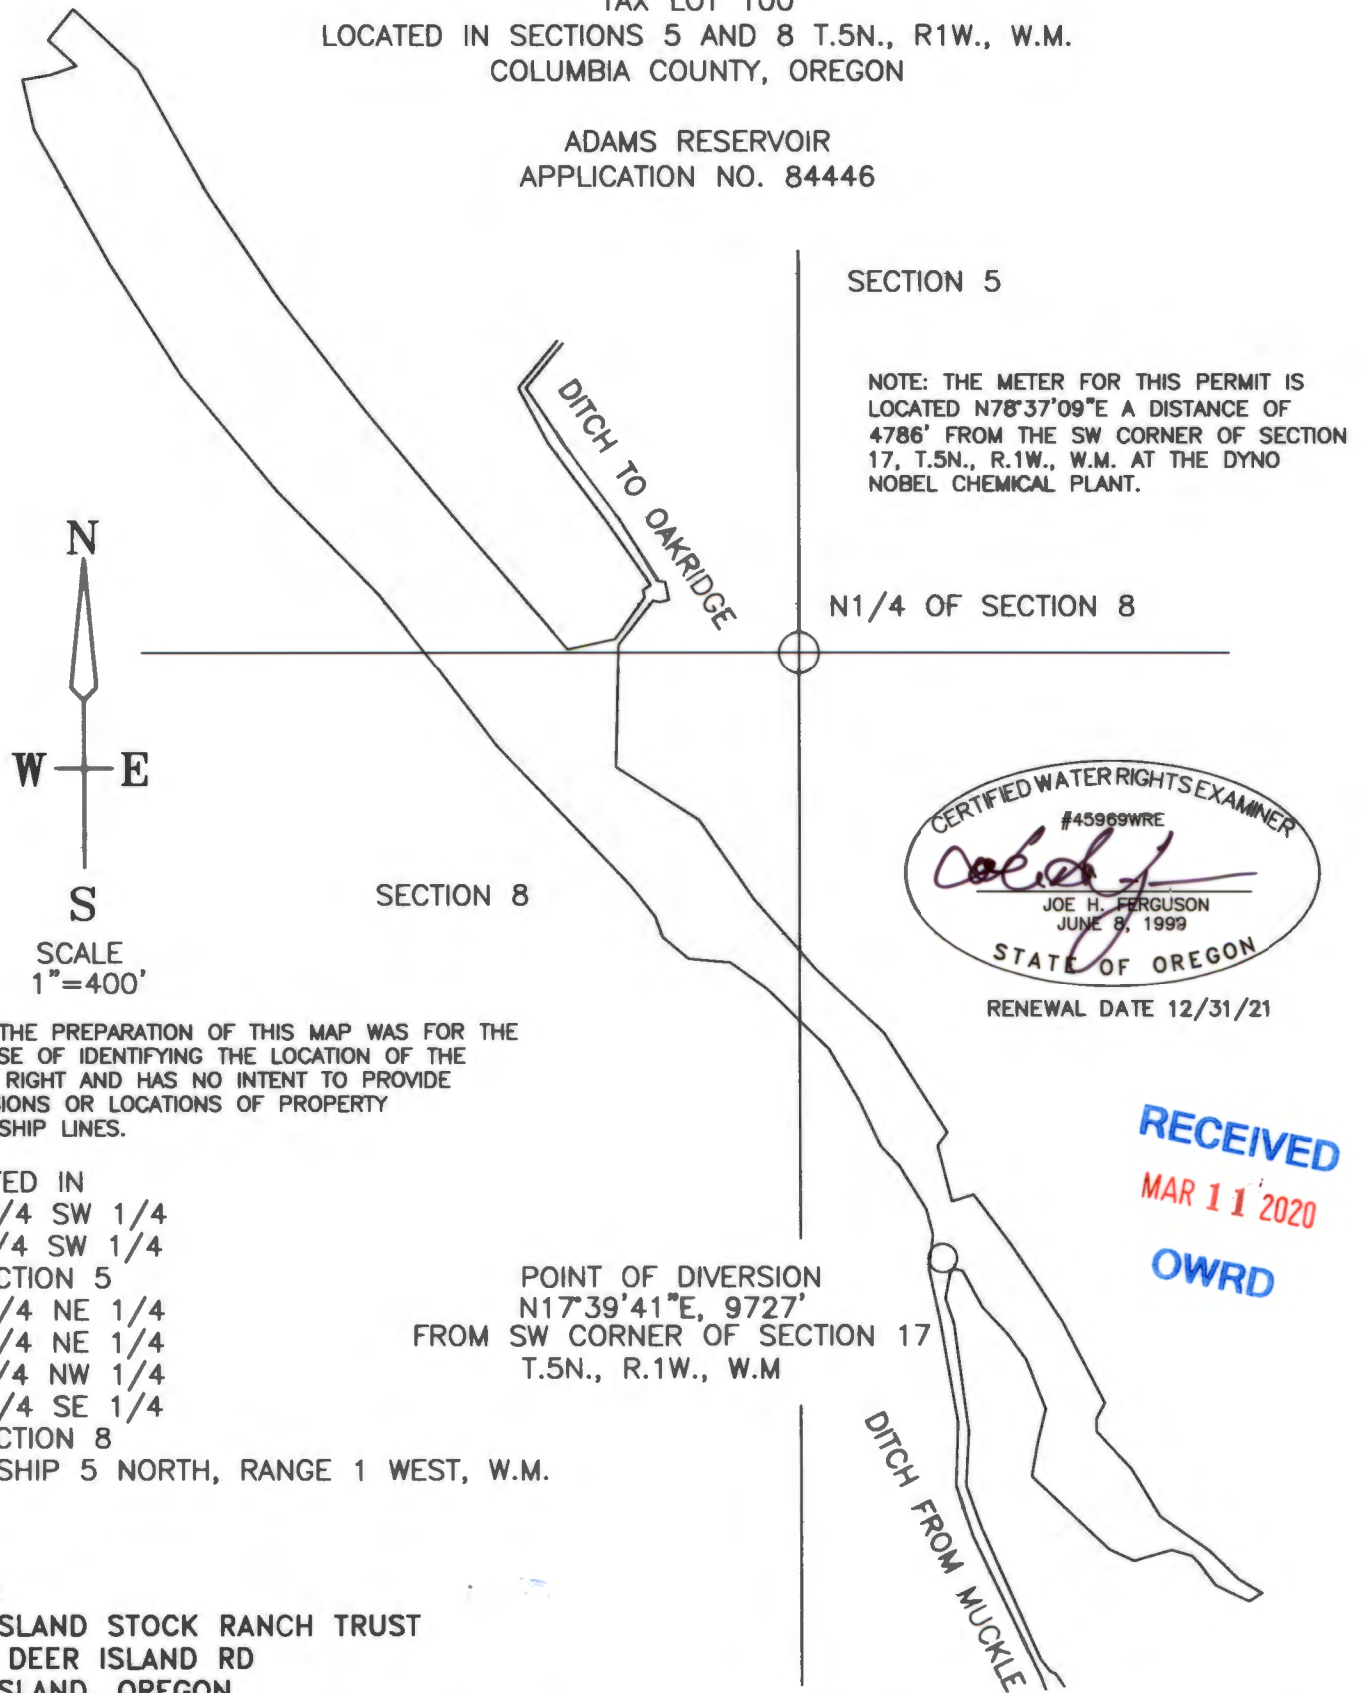

NOTE: THE PREPARATION OF THIS MAP WAS FOR THE PURPOSE OF IDENTIFYING THE LOCATION OF THE WATER RIGHT AND HAS NO INTENT TO PROVIDE DIMENSIONS OR LOCATIONS OF PROPERTY OWNERSHIP LINES.

LOCATED IN

SW 1/4 SW 1/4

SE 1/4 SW 1/4

SECTION 5

NW 1/4 NE 1/4

SW 1/4 NE 1/4

NE 1/4 NW 1/4

NW 1/4 SE 1/4

SECTION 8

TOWNSHIP 5 NORTH, RANGE 1 WEST, W.M.

CLIENT:

DEER ISLAND STOCK RANCH TRUST

65640 DEER ISLAND RD

DEER ISLAND, OREGON

Ferguson Land Surveying, Inc.

646 SE 106TH AVE. PORTLAND, OR 97216

Phone (503) 408-0601 Fax (503) 408-0602

SHEET NO. 1 OF 1

JOB NO. 15-197CBU AR

DRAFTED 3.10.2020