


CLAIM OF BENEFICIAL USE MAP
DEER ISLAND STOCK RANCH TRUST
TAX LOT 100
LOCATED IN SECTIONS 5 AND 6, T.5N., R.1W., W.M.
COLUMBIA COUNTY, OREGON

OAK RIDGE RESERVOIR
APPLICATION NO. 84447

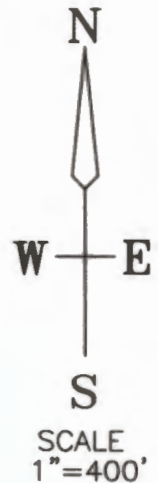


RECEIVED

MAR 11 2020

OWRD

NOTE: THE METER FOR THIS PERMIT IS LOCATED
N78°37'09"E A DISTANCE OF 4786' FROM THE SW
CORNER OF SECTION 17, T.5N., R.1W., W.M. AT THE
DYNO NOBEL CHEMICAL PLANT.

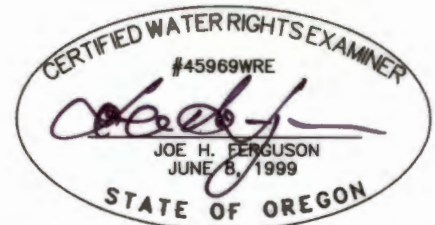

RENEWAL DATE 12/31/21

POINT OF DIVERSION
N11°23'27"E, 11,565'
FROM SW CORNER OF SECTION 17
T.5N., R.1W., W.M.

DITCH FROM ADAMS

DITCH TO OTTER

N1/4 OF SECTION 8

SECTION 5

SECTION 8

NOTE: THE PREPARATION OF THIS MAP WAS FOR THE
PURPOSE OF IDENTIFYING THE LOCATION OF THE
WATER RIGHT AND HAS NO INTENT TO PROVIDE
DIMENSIONS OR LOCATIONS OF PROPERTY
OWNERSHIP LINES.

LOCATED IN
SW 1/4 NW 1/4
NW 1/4 SW 1/4
SW 1/4 SW 1/4
SE 1/4 SW 1/4
SECTION 5
NW 1/4 NE 1/4
SECTION 8
T.5N., R.1W., W.M.

CLIENT:
DEER ISLAND STOCK RANCH TRUST
65640 DEER ISLAND RD
DEER ISLAND, OREGON

Ferguson Land Surveying, Inc.

646 SE 106TH AVE. PORTLAND, OR 97216
Phone (503) 408-0601 Fax (503) 408-0602

SHEET NO. 1 OF 1

JOB NO. 15-197CBU QR

DRAFTED 3.10.2020