

CLAIM OF BENEFICIAL USE MAP

DEER ISLAND STOCK RANCH TRUST

TAX LOT 100

LOCATED IN SECTION 5, T.5N., R.1W., W.M.

AND SECTION 32, T.6N., R.1W., W.M.

COLUMBIA COUNTY, OREGON

OTTER RESERVOIR

APPLICATION NO. 84448

NOTE: THE METER FOR THIS PERMIT IS LOCATED
N78°37'09"E A DISTANCE OF 4786' FROM THE SW
CORNER OF SECTION 17, T.5N., R.1W., W.M. AT THE
DYNO NOBEL CHEMICAL PLANT.




SCALE
1"=1320'

T.5N., R.1W., W.M.
SECTION 5
NE 1/4 NW 1/4

T.6N., R.1W., W.M.
SE 1/4 NW 1/4
NE 1/4 SW 1/4
NW 1/4 SW 1/4
SW 1/4 SW 1/4
SE 1/4 SW 1/4
SECTION 32

SW CORNER SECTION 32

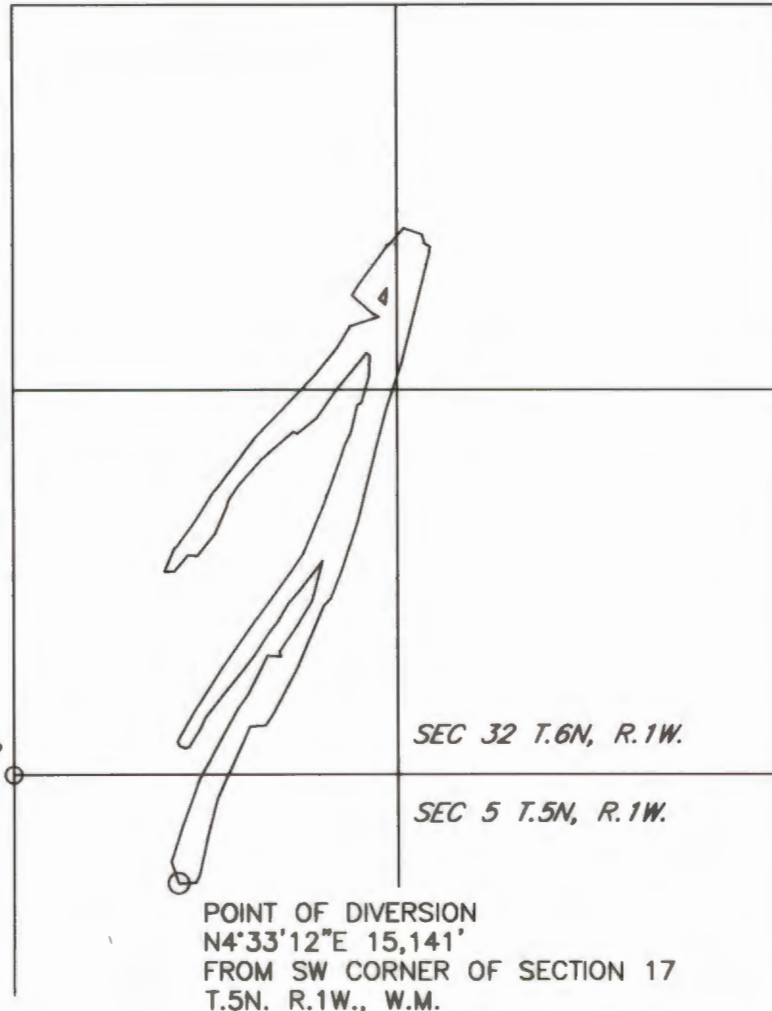


RECEIVED
MAR 11 2020
OWRD

NOTE: THE PREPARATION OF THIS MAP WAS FOR THE
PURPOSE OF IDENTIFYING THE LOCATION OF THE
WATER RIGHT AND HAS NO INTENT TO PROVIDE
DIMENSIONS OR LOCATIONS OF PROPERTY
OWNERSHIP LINES.

CLIENT:

DEER ISLAND STOCK RANCH TRUST
65640 DEER ISLAND RD
DEER ISLAND, OREGON

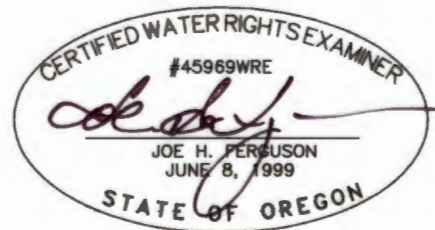

RENEWAL DATE 12/31/21

Ferguson Land Surveying, Inc.

646 SE 106TH AVE. PORTLAND, OR 97216

Phone (503) 408-0601 Fax (503) 408-0602

SHEET NO. 1 OF 1

JOB NO. 15-197CBU OT

DRAFTED 3.20.2020