

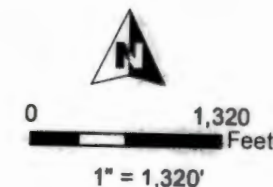


**T22S, R32E,
SECTION 34, WM**

HARNEY COUNTY, OREGON

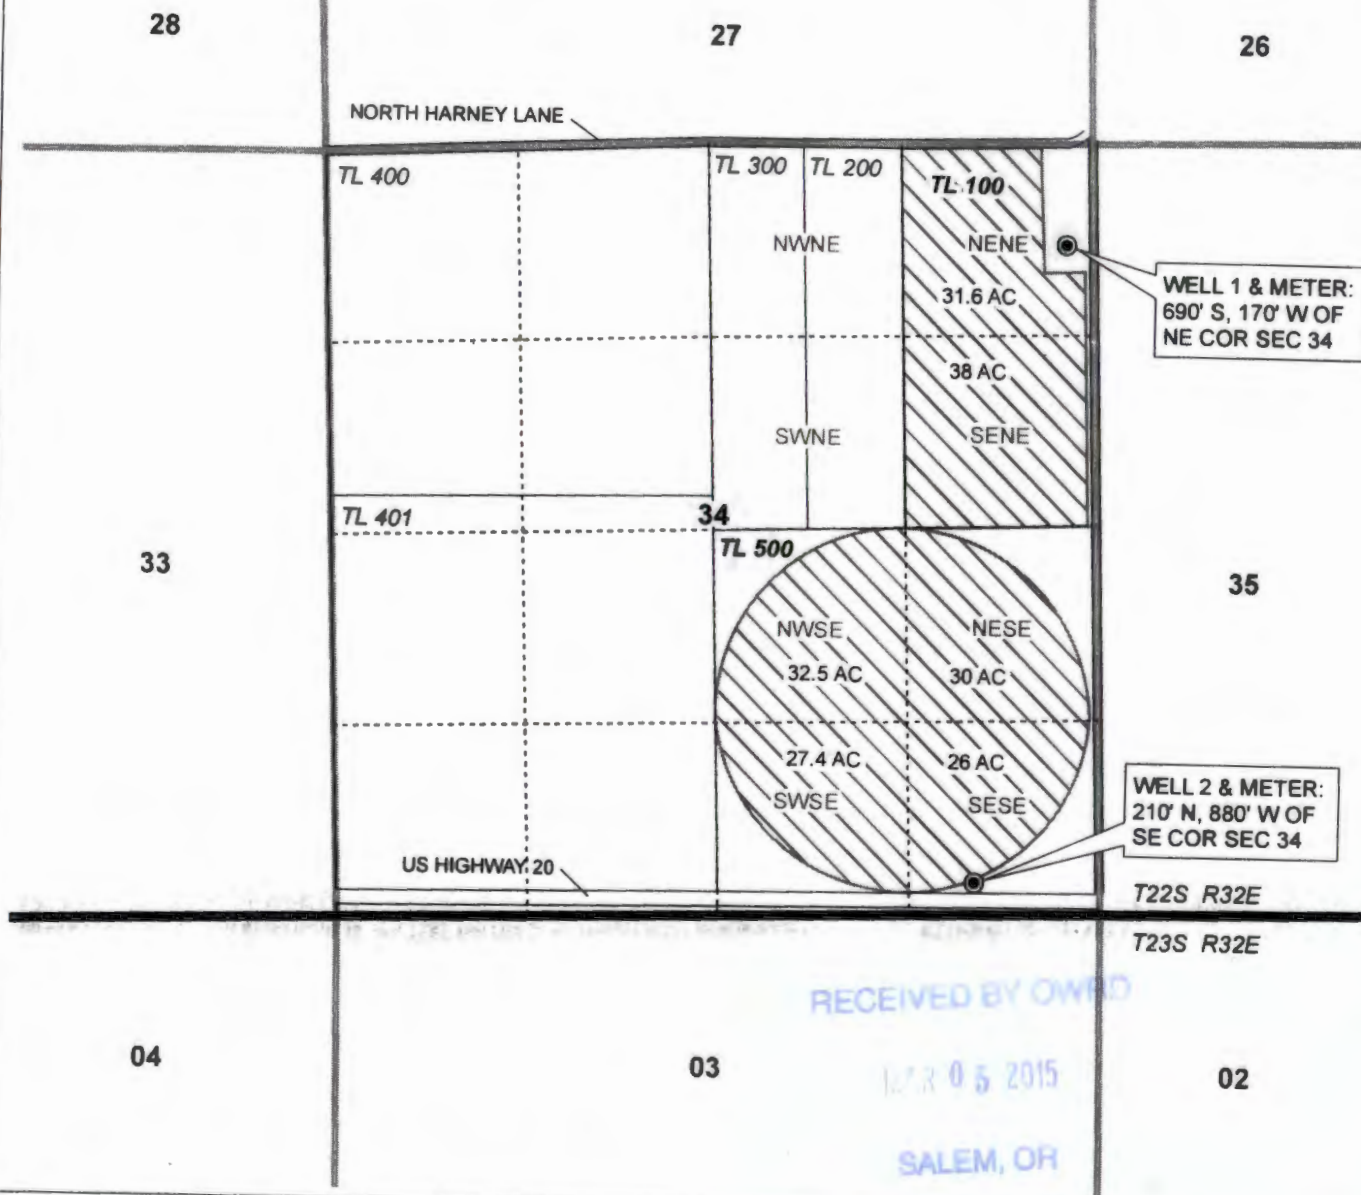

- POU Irrigation (185.5 acres)
- Township
- Section
- Quarter Quarter
- Taxlot
- Well

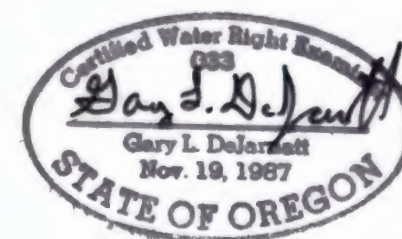

RENEWAL DATE 12/31/2015

CLAIM OF BENEFICIAL USE MAP
Vogler

NOTE: THIS MAP IS NOT INTENDED TO
PROVIDE LEGAL DIMENSIONS OR LOCATIONS
OF PROPERTY OWNERSHIP LINES.

WATER RIGHT SERVICES, LLC
PO BOX 1830, BEND, OR 97709
CCB# 197121 www.oregonwater.us
541-389-2837 JOHNSHORT@USA.COM

AP G-16263

PERMIT G-15825

PROJECT #15004

FEBRUARY 4, 2015

RECEIVED BY OWRD

MAR 05 2015

SALEM, OR