

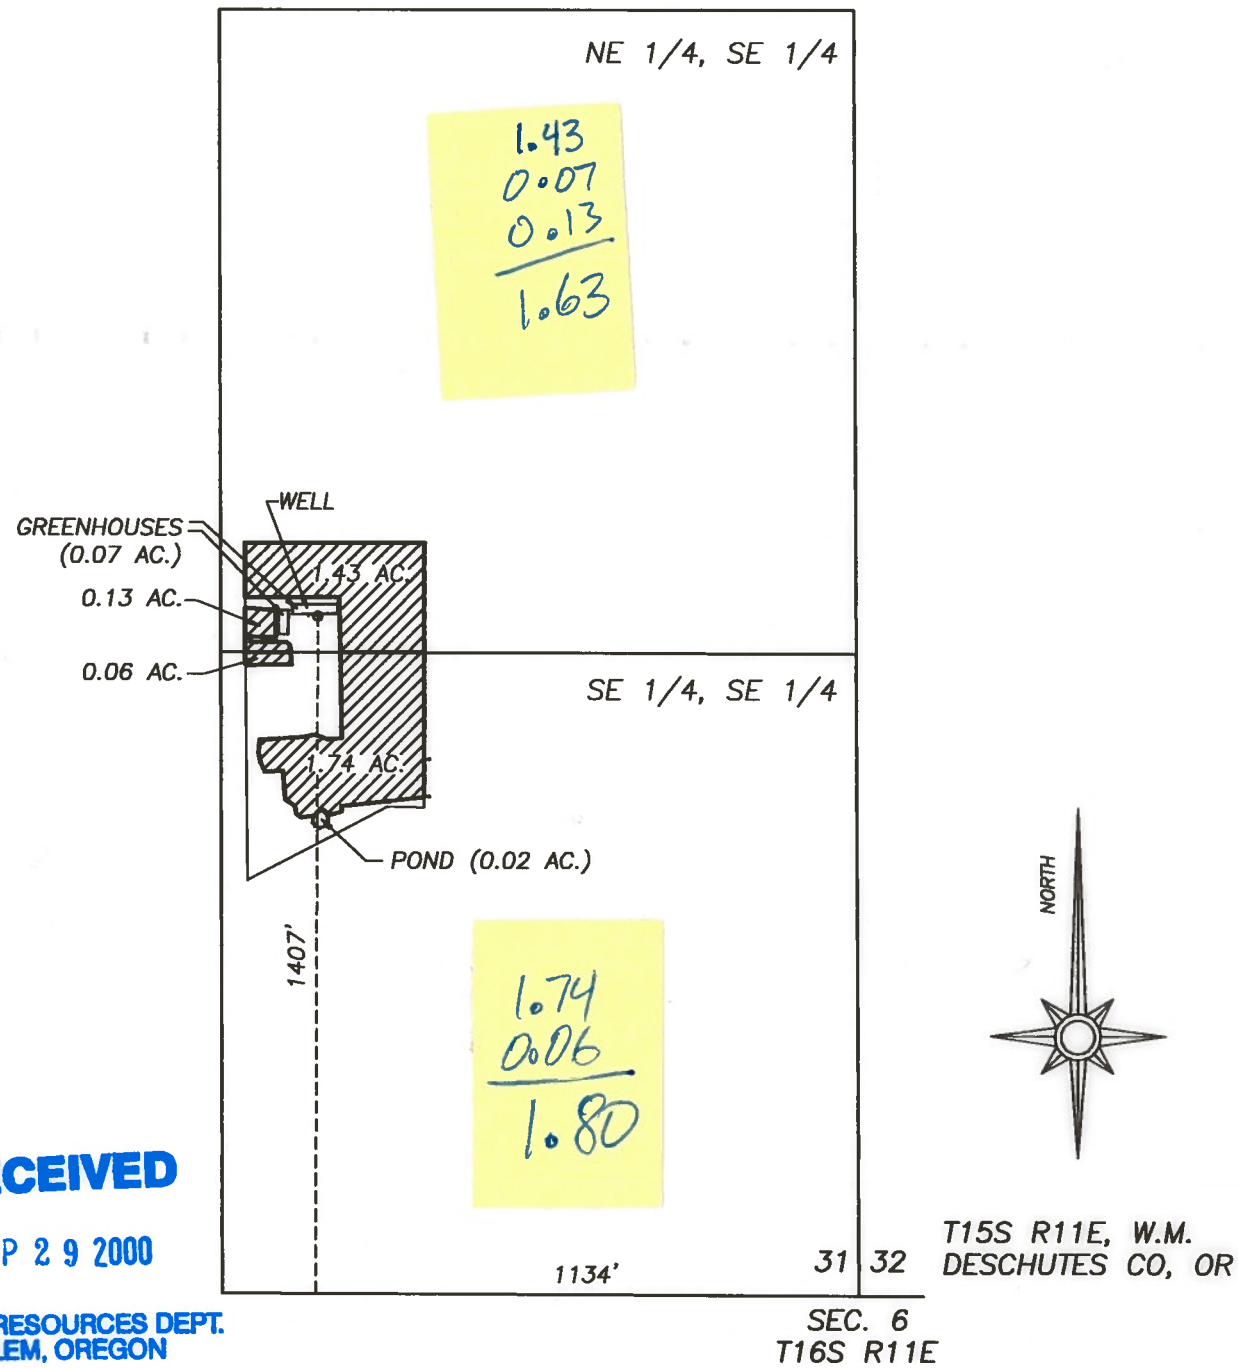
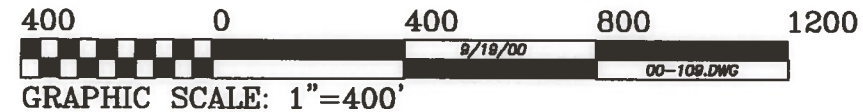


# FINAL PROOF SURVEY

APPLICATION NO. G-14012, PERMIT NO. G-12679  
 TO APPROPRIATE GROUNDWATER  
 FOR A PARCEL OF LAND SITUATED IN THE E 1/2, SE 1/4,  
 SEC. 31, T15S, R11E, W.M., DESCHUTES COUNTY, OREGON

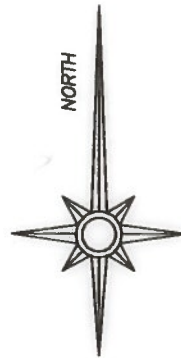

IRRIGATED AREA = 3.36 ACRES  
 GREENHOUSE AREA = 0.07 ACRE

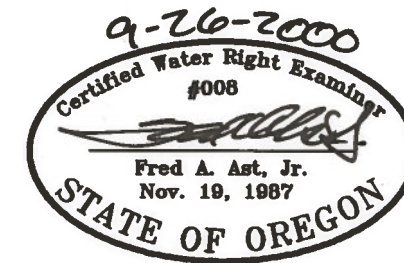

RECEIVED  
 SEP 29 2000

WATER RESOURCES DEPT.  
 SALEM, OREGON

Fred A. Ast, Jr. and Associates

250 W. Cascade Avenue

P.O. Box 751

Sisters, Oregon 97759

541-549-7851