


CLAIM OF BENEFICIAL USE MAP
NOELLA SLANEY & FRANK DESHONG
APPLICATION FILE #S-85976; PERMIT #S-54111
SW 1/4 NE 1/4 SECTION 26 TOWNSHIP 19 SOUTH,
RANGE 12 WEST, W.M.
LANE COUNTY, OREGON
ASSESSOR'S MAP 19-12-26-13, TAX LOT 3501

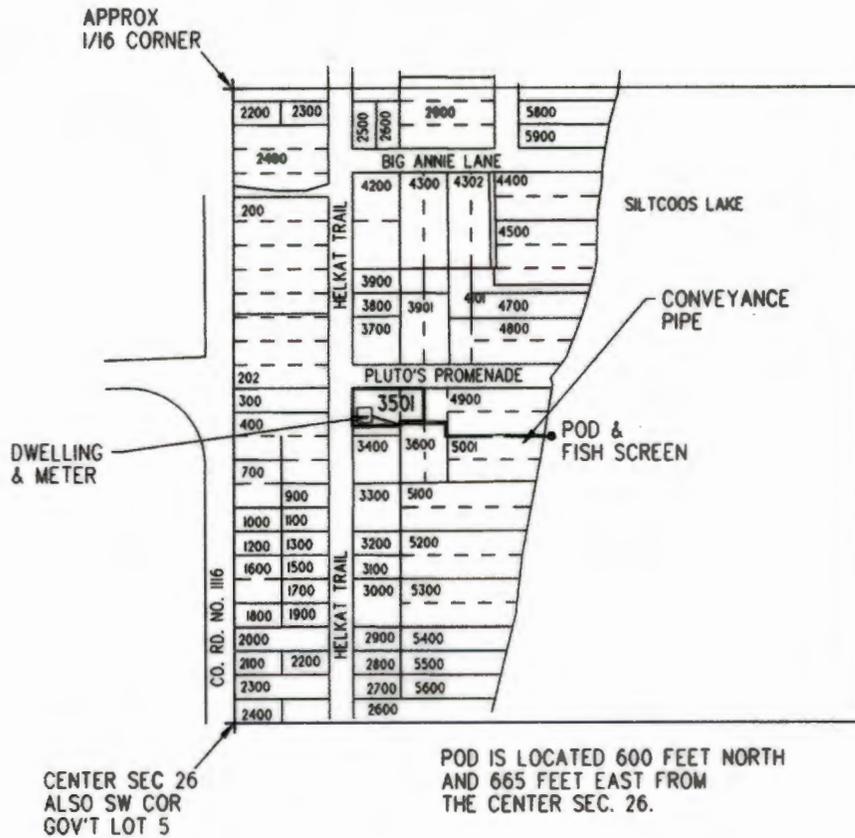

Certified Water Right Examiner
 104 WRE
Thomas F. Poage
 Thomas F. Poage
 Nov. 19, 1987
 STATE OF OREGON
 ex 12/31/18

RECEIVED
 JAN 2 2018
 OWRD

THIS MAP IS NOT INTENDED TO PROVIDE LEGAL DIMENSIONS OR LOCATIONS OF PROPERTY OWNERSHIP LINES