



MAP TO ACCOMPANY CLAIM OF BENEFICIAL USE
 LOCATED IN THE S1/2 OF THE S1/2 OF SECTION 27 AND
 THE N1/2 OF THE N1/2 OF SECTION 34, T10S, R23E, W.M.,
 WHEELER COUNTY, OREGON
 TAX LOT: 10-23-0000-00500

APPLICATION NO. R-87409
 PERMIT NO. R-15256

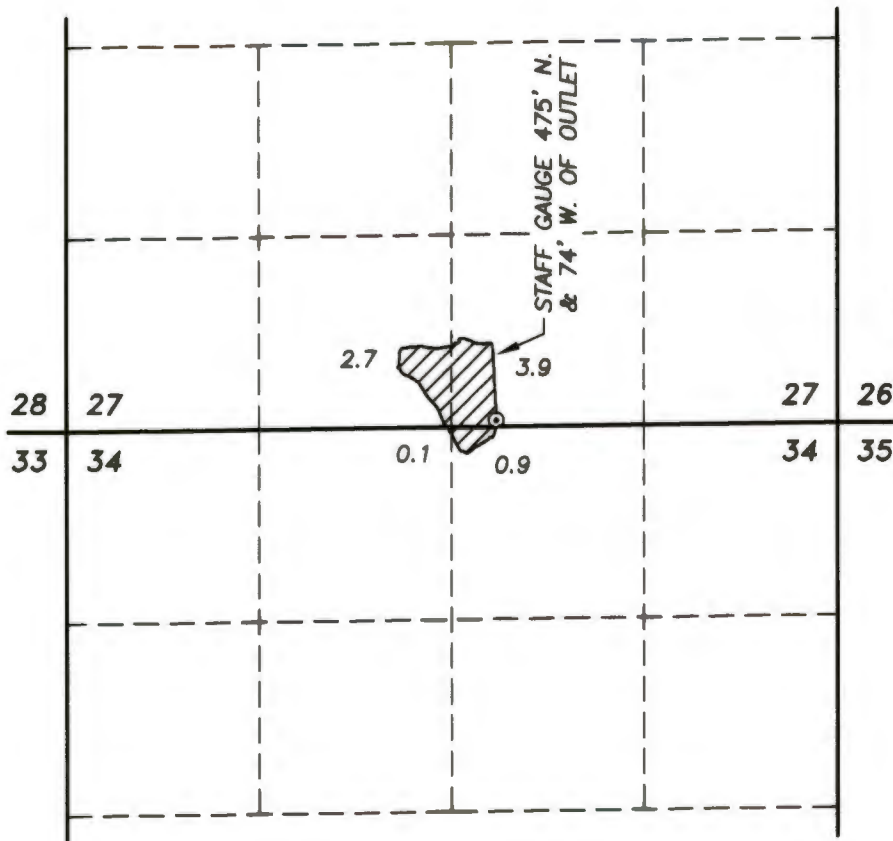

SCALE 1" = 1320'

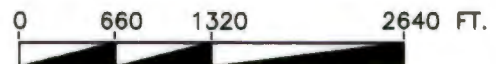

RECEIVED


JUL 23 2018

OWRD

LEGEND

- SECTION LINE
- - - 1/4, 1/4 SECTION LINE
- ⊙ DAM OUTLET - 2340 FT. WEST AND 50 FT. NORTH OF SOUTHEAST CORNER SECTION 27
 LAT. N 44°39'59.8" LONG. W 119°56'52.5"
 (WGS84 DATUM)
-  AREA SUBMERGED BY EXISTING RESERVOIR.
 7.604 ACRES (±79.32 ACRE FEET).

NOTE: PREPARATION OF THIS MAP IS FOR PURPOSES OF IDENTIFYING PROPOSED WATER RIGHTS ONLY. IT HAS NO INTENT TO PROVIDE LOCATIONS OR DIMENSIONS OF PROPERTY BOUNDARIES.

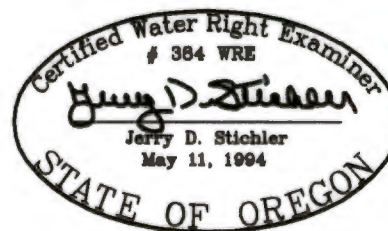

06/29/18

RENEWAL 6/30/20

PERMIT HOLDER:
 JIM HAMEL
 2357 HILLSIDE ROAD
 RICHFIELD, WISCONSIN 53076
 JUNE 5, 2018 SHEET 1 OF 1

DRAWN BY: J.S.

ACAD: 1761_FP3