


Claim of Beneficial Use Map Point of Appropriation Port of Portland

Multnomah County, Oregon
Application G-14488, Permit G-17888
Township 1 North, Range 2 East (W.M.)

RECEIVED

51 18 10

0000

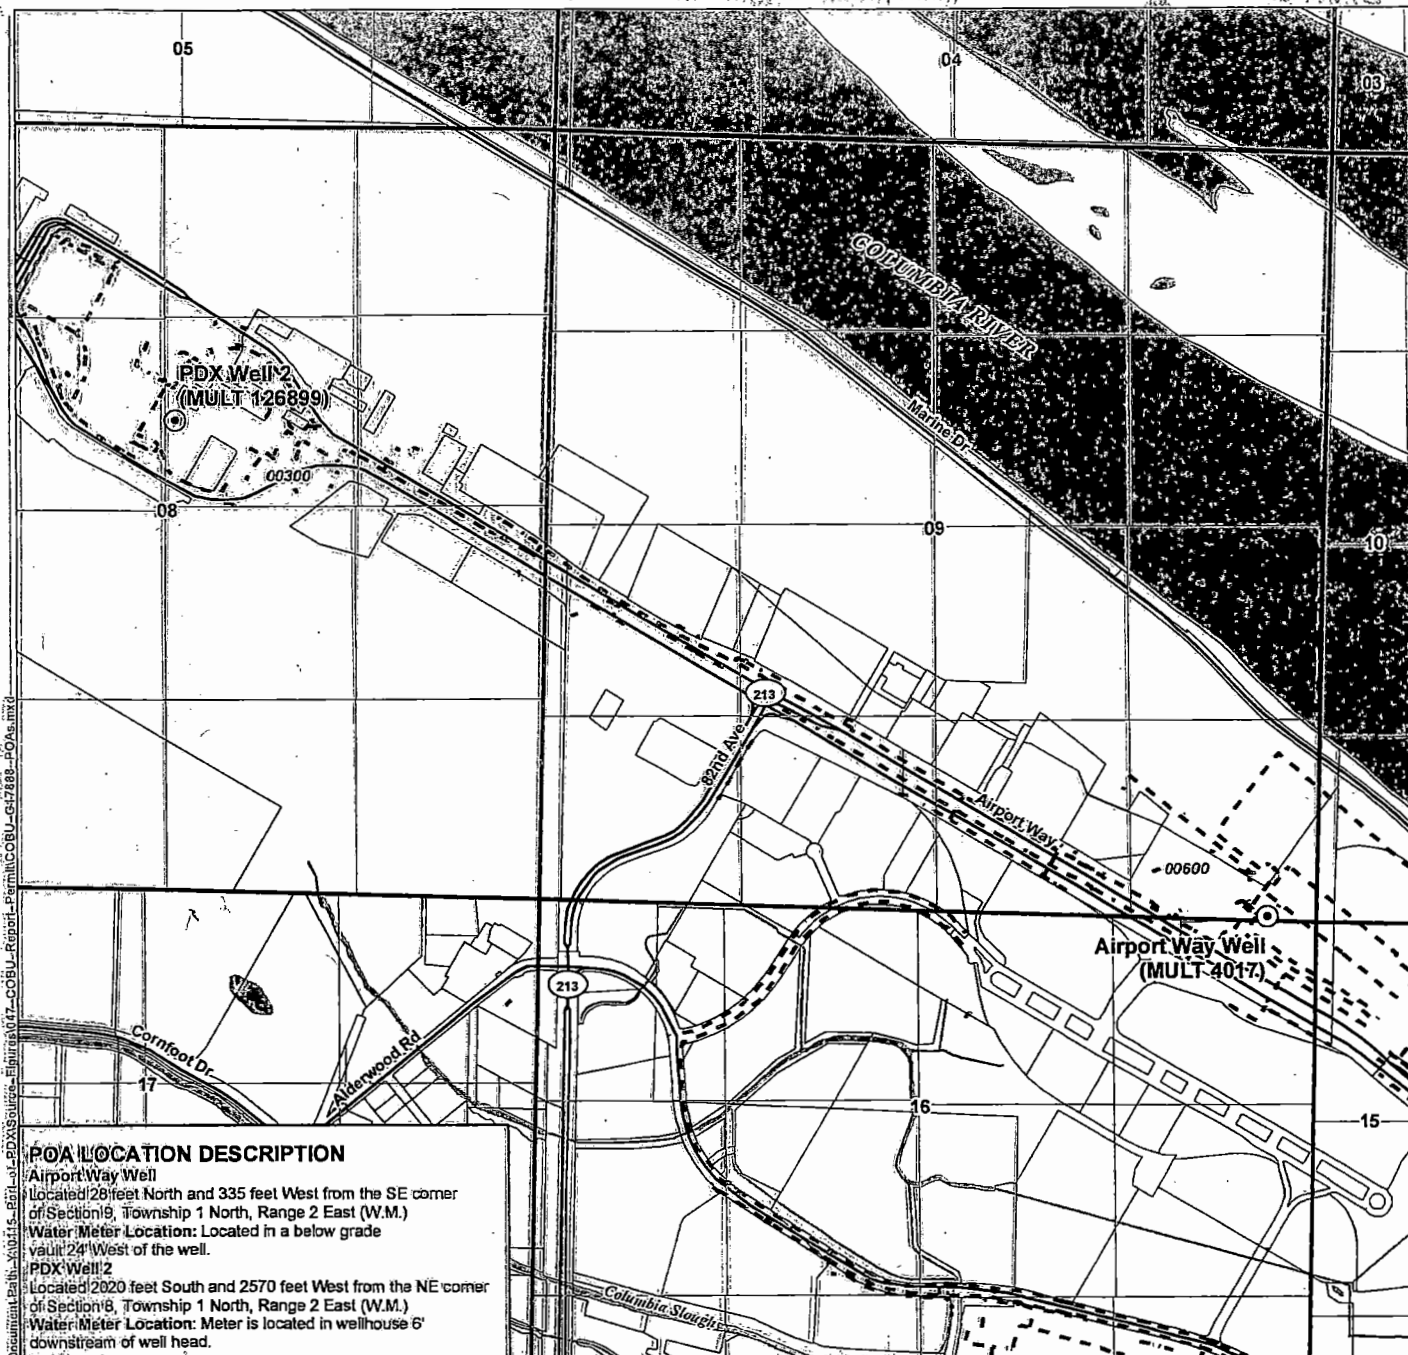

POA LOCATION DESCRIPTION

Airport Way Well

Located 28 feet North and 335 feet West from the SE corner of Section 9, Township 1 North, Range 2 East (W.M.)

Water Meter Location: Located in a below grade vault 24' West of the well.

PDX Well 2

Located 2020 feet South and 2570 feet West from the NE corner of Section 8, Township 1 North, Range 2 East (W.M.)

Water Meter Location: Meter is located in wellhouse 6' downstream of well head.

LEGEND

- ⊙ Authorized Point of Appropriation (POA)
- Waterline
- All Other Features
- ⊕ Tax Lot
- == Major Road
- ~ Watercourse
- Waterbody

Certified Water Rights Examiner Stamp




DISCLAIMER

This map was prepared for the purpose of identifying the location of a water right only and it is not intended to provide legal dimensions or location of property ownership lines.

MAP NOTES

Date: November 13, 2019

Data Sources: USGS, METRO, OGIC, BLM

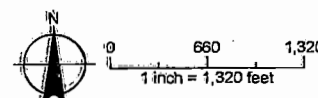


Claim of Beneficial Use Map Place of Use Port of Portland

Multnomah County, Oregon
Application G-14488, Permit G-17888
Township 1 North, Range 2 East (W.M.)

RECEIVED

NOV 14 2019

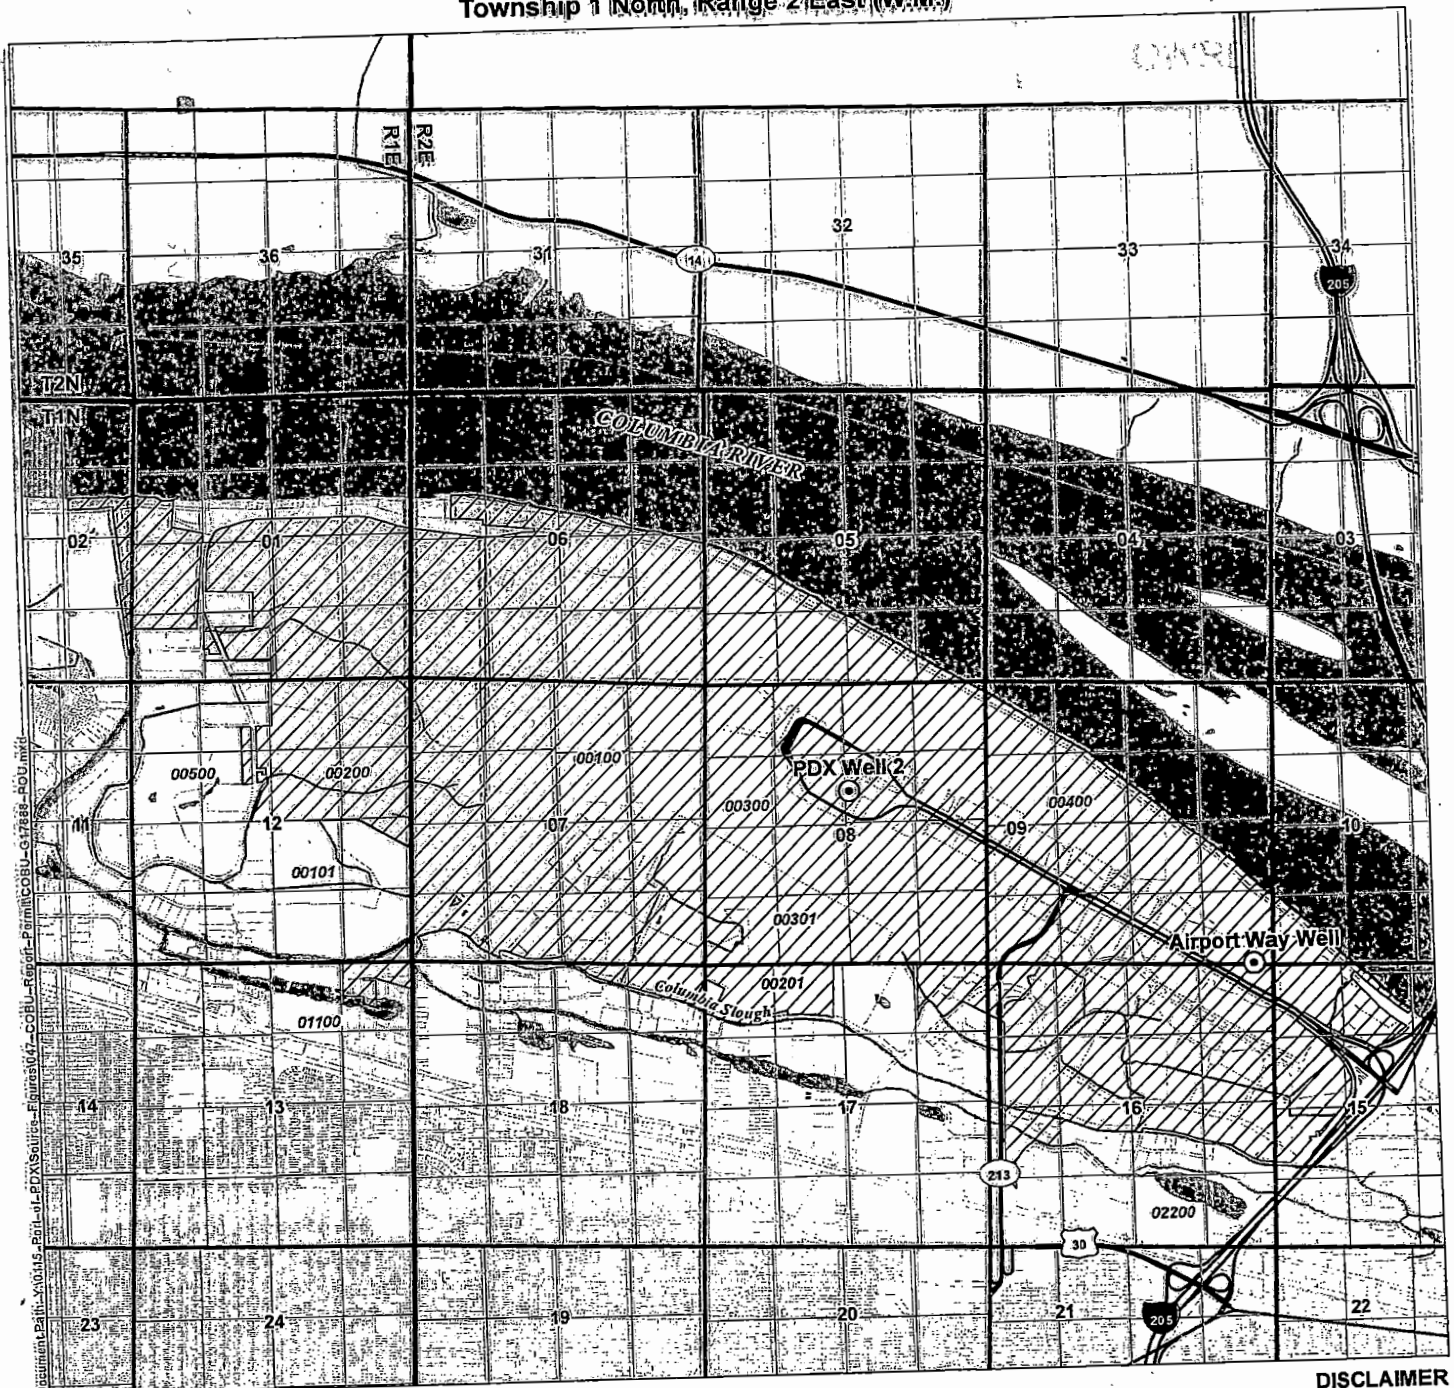

DISCLAIMER

This map was prepared for the purpose of identifying the location of a water right only and it is not intended to provide legal dimensions or location of property ownership lines.

MAP NOTES


Date: October 7, 2019

Data Sources: USGS, METRO, OGIC, BLM

LEGEND

- ⊙ Authorized Point of Appropriation (POA)
- ▨ Place of Use (POU)
- All Other Features
 - Tax Lot
 - Major Road
 - Watercourse
 - Waterbody

Certified Water Rights Examiner Stamp

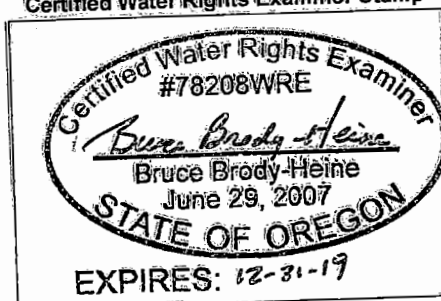

10 1,800 3,600
1 inch = 3,600 feet

