

1.0 SW SW -29
 0.8 SE SW -29
 0.6 NE NW -32
 0.8 NW NE -32
 0.1 NW NW -32
 3.3

1.0 SW SW -29
 2.1 NE NW -32
 0.2 NW NE -32
 3.5

CERT 3153
 CERT 94327 (33)

2.3 SW NE } FROM
 4.9 NE SE } FROM
 7.2

4.6 SE NE } TO
 2.6 NE SE } TO
 7.2

CLEARWATER DITCH POD
 1283' N, 313' E FROM
 SW COR SEC 33
 T1N R43E
 FOR CERT 3153

FOSTER DITCH
 POD 820' S, 625' W
 FROM CENTER OF
 SEC 4, T1S, R43E
 FOR CERT 94327

RECEIVED
 JUN 1 2020
 OWRD

LEGEND


OR = ORIGINAL RIGHT
 RE = REMAINING RIGHT

JOHNSTON
 [Symbol] TO LAND 3153
 [Symbol] FROM LAND 3153

BAKER
 [Symbol] TO LAND 94327
 [Symbol] FROM LAND 94327

NO NET CHANGE IN LANDS IRRIGATED. POU CHANGE IS TO ACCOMMODATE CENTER PIVOT IRRIGATION

THIS MAP IS PREPARED FOR WATER RIGHT PURPOSES ONLY AND SHOULD NOT BE USED FOR PROPERTY LOCATION PURPOSES

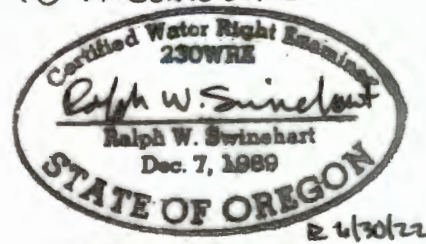

CW APP CW-111
 CHANGE IN PLACE OF USE FOR CERT
 3153 AND CERT 94327
 T1N R43E SEC 29 & 32
 WALLOWA COUNTY

FINAL PROOF MAP FOR:
 FERRY JOHNSTON KEN & BOBBIE BAKER
 81703 HWY 82 81705 HWY 82
 WALLOWA, OREGON 97885
 PREPARED BY WALLOWA NATN BANK NUMBERING
 ENTERPRISE, OREGON 612020