

RECEIVED

MAR 12 2020

OWRD

31

TAX LOT 8600
199.74 AC
(BAKER)

32

33

R 43E

36 AC
NW SE

BAKER
10" MAIN

348 AC
SW SE

JOHNSON
8" MAIN

FOSTER RIVER

BASE LINE

TIN

TAX LOT
8800
36.92 AC
(JOHNSON)

15" PVC

SCREEN

5 FOSTER DITCH


4
NEW
FOSTER DITCH
POD, 320'S
625' W OF
CENTER SEC 4
T1S R43E

6



HWY 82

9

LEGEND

 LAND IRRIGATED UNDER CERT 94163 FROM MILES DITCH TO HAVE ITS POD CHANGED TO FOSTER DITCH AS PART OF CW-111

FORMER MILES DITCH POD FOR CERT 94163 WAS IN THE SENE SEC 9, T1S, R43E

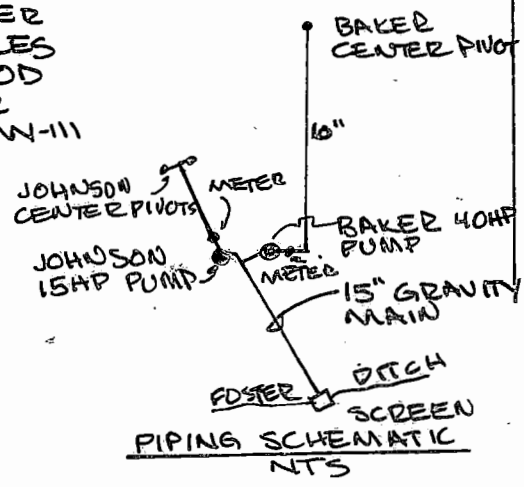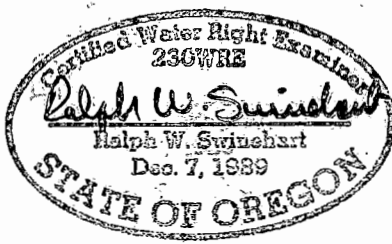

1"=2000'

THIS MAP IS PREPARED FOR WATERRIGHT PURPOSES AND SHOULD NOT BE USED FOR PROPERTY LOCATION PURPOSES

CW APP CW-111
CHANGE OF POD FOR CERT 94163
SEE P. 12
T1N R43E & T1S R43E
WALLOWA COUNTY

FINAL PROOF MAP FOR
PERRY JOHNSON & KEN AND BOBBIE BAKER
81703 HWY 82 81705 HWY 82
WALLOWA, OREGON 97885
PREPARED BY WALLOWA Mtn ENGINEERING
ENTERPRISE, OREGON 2/2020