



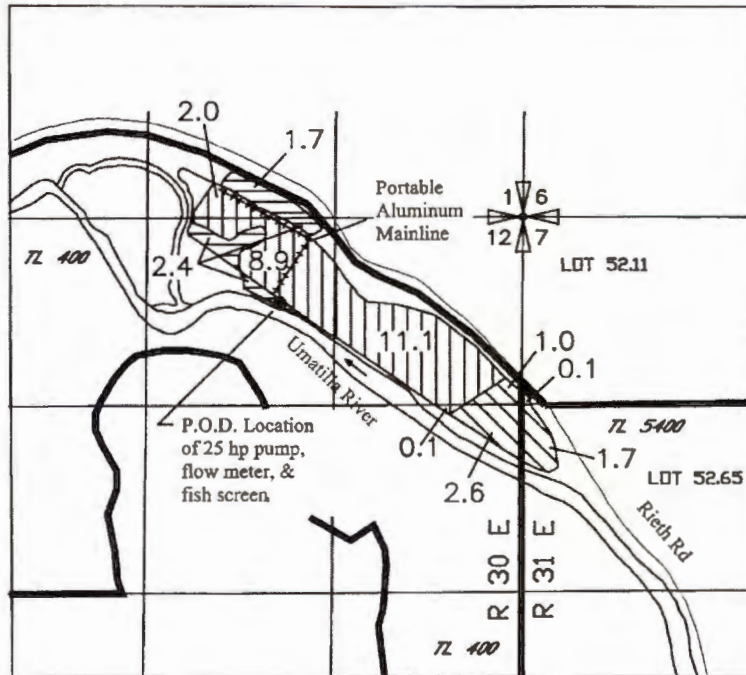

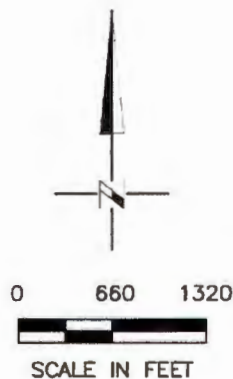



REVISED (7/21/20)
 CLAIM OF BENEFICIAL USE MAP
 FOR TRANSFER 10948
 IN THE NAME OF B & G RESOURCES
 c/o KENNETH E. GUSTAFSON
 SECTIONS 1 & 12, T2N, R30E & R31E, WM
 UMATILLA COUNTY




LEGEND



-  4.1 AC OF ORIGINATING CERT 80564 TRANSFERRED TO A NEW LOCATION AND PROVIDED WITH NEW P.O.D.
-  22.1 AC OF ORIGINATING CERT 80564 WATER RIGHT THAT ONLY INVOLVED A CHANGE IN P.O.D.
-  5.4 AC OF ORIGINATING CERT 83483 WATER RIGHT THAT ONLY INVOLVED A CHANGE IN P.O.D.
-  TL 5400 TAX LOT (TYP)
-  P.O.D. LOCATION: 540 FT SOUTH AND 1660 FEET WEST FROM THE NE CORNER OF SEC 12
-  PORTABLE ALUMINUM PIPELINE

RECEIVED
JUL 29 2020
OWRD

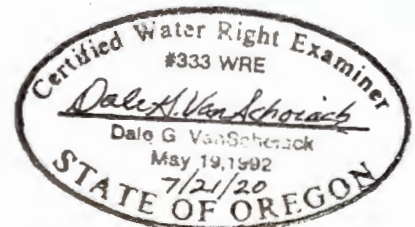

Renewal 6/30/22

DGV Consulting, PLLC
 PHONE (509) 627-8717
 dalevconsulting@gmail.com
 Date: July 21, 2020

NOTE: THE PURPOSE OF THIS MAP IS TO IDENTIFY THE APPROXIMATE LOCATION OF THE WATER RIGHT. IT IS NOT INTENDED TO PROVIDE INFORMATION RELATIVE TO THE LOCATION OF PROPERTY OWNERSHIP BOUNDARY LINES.