


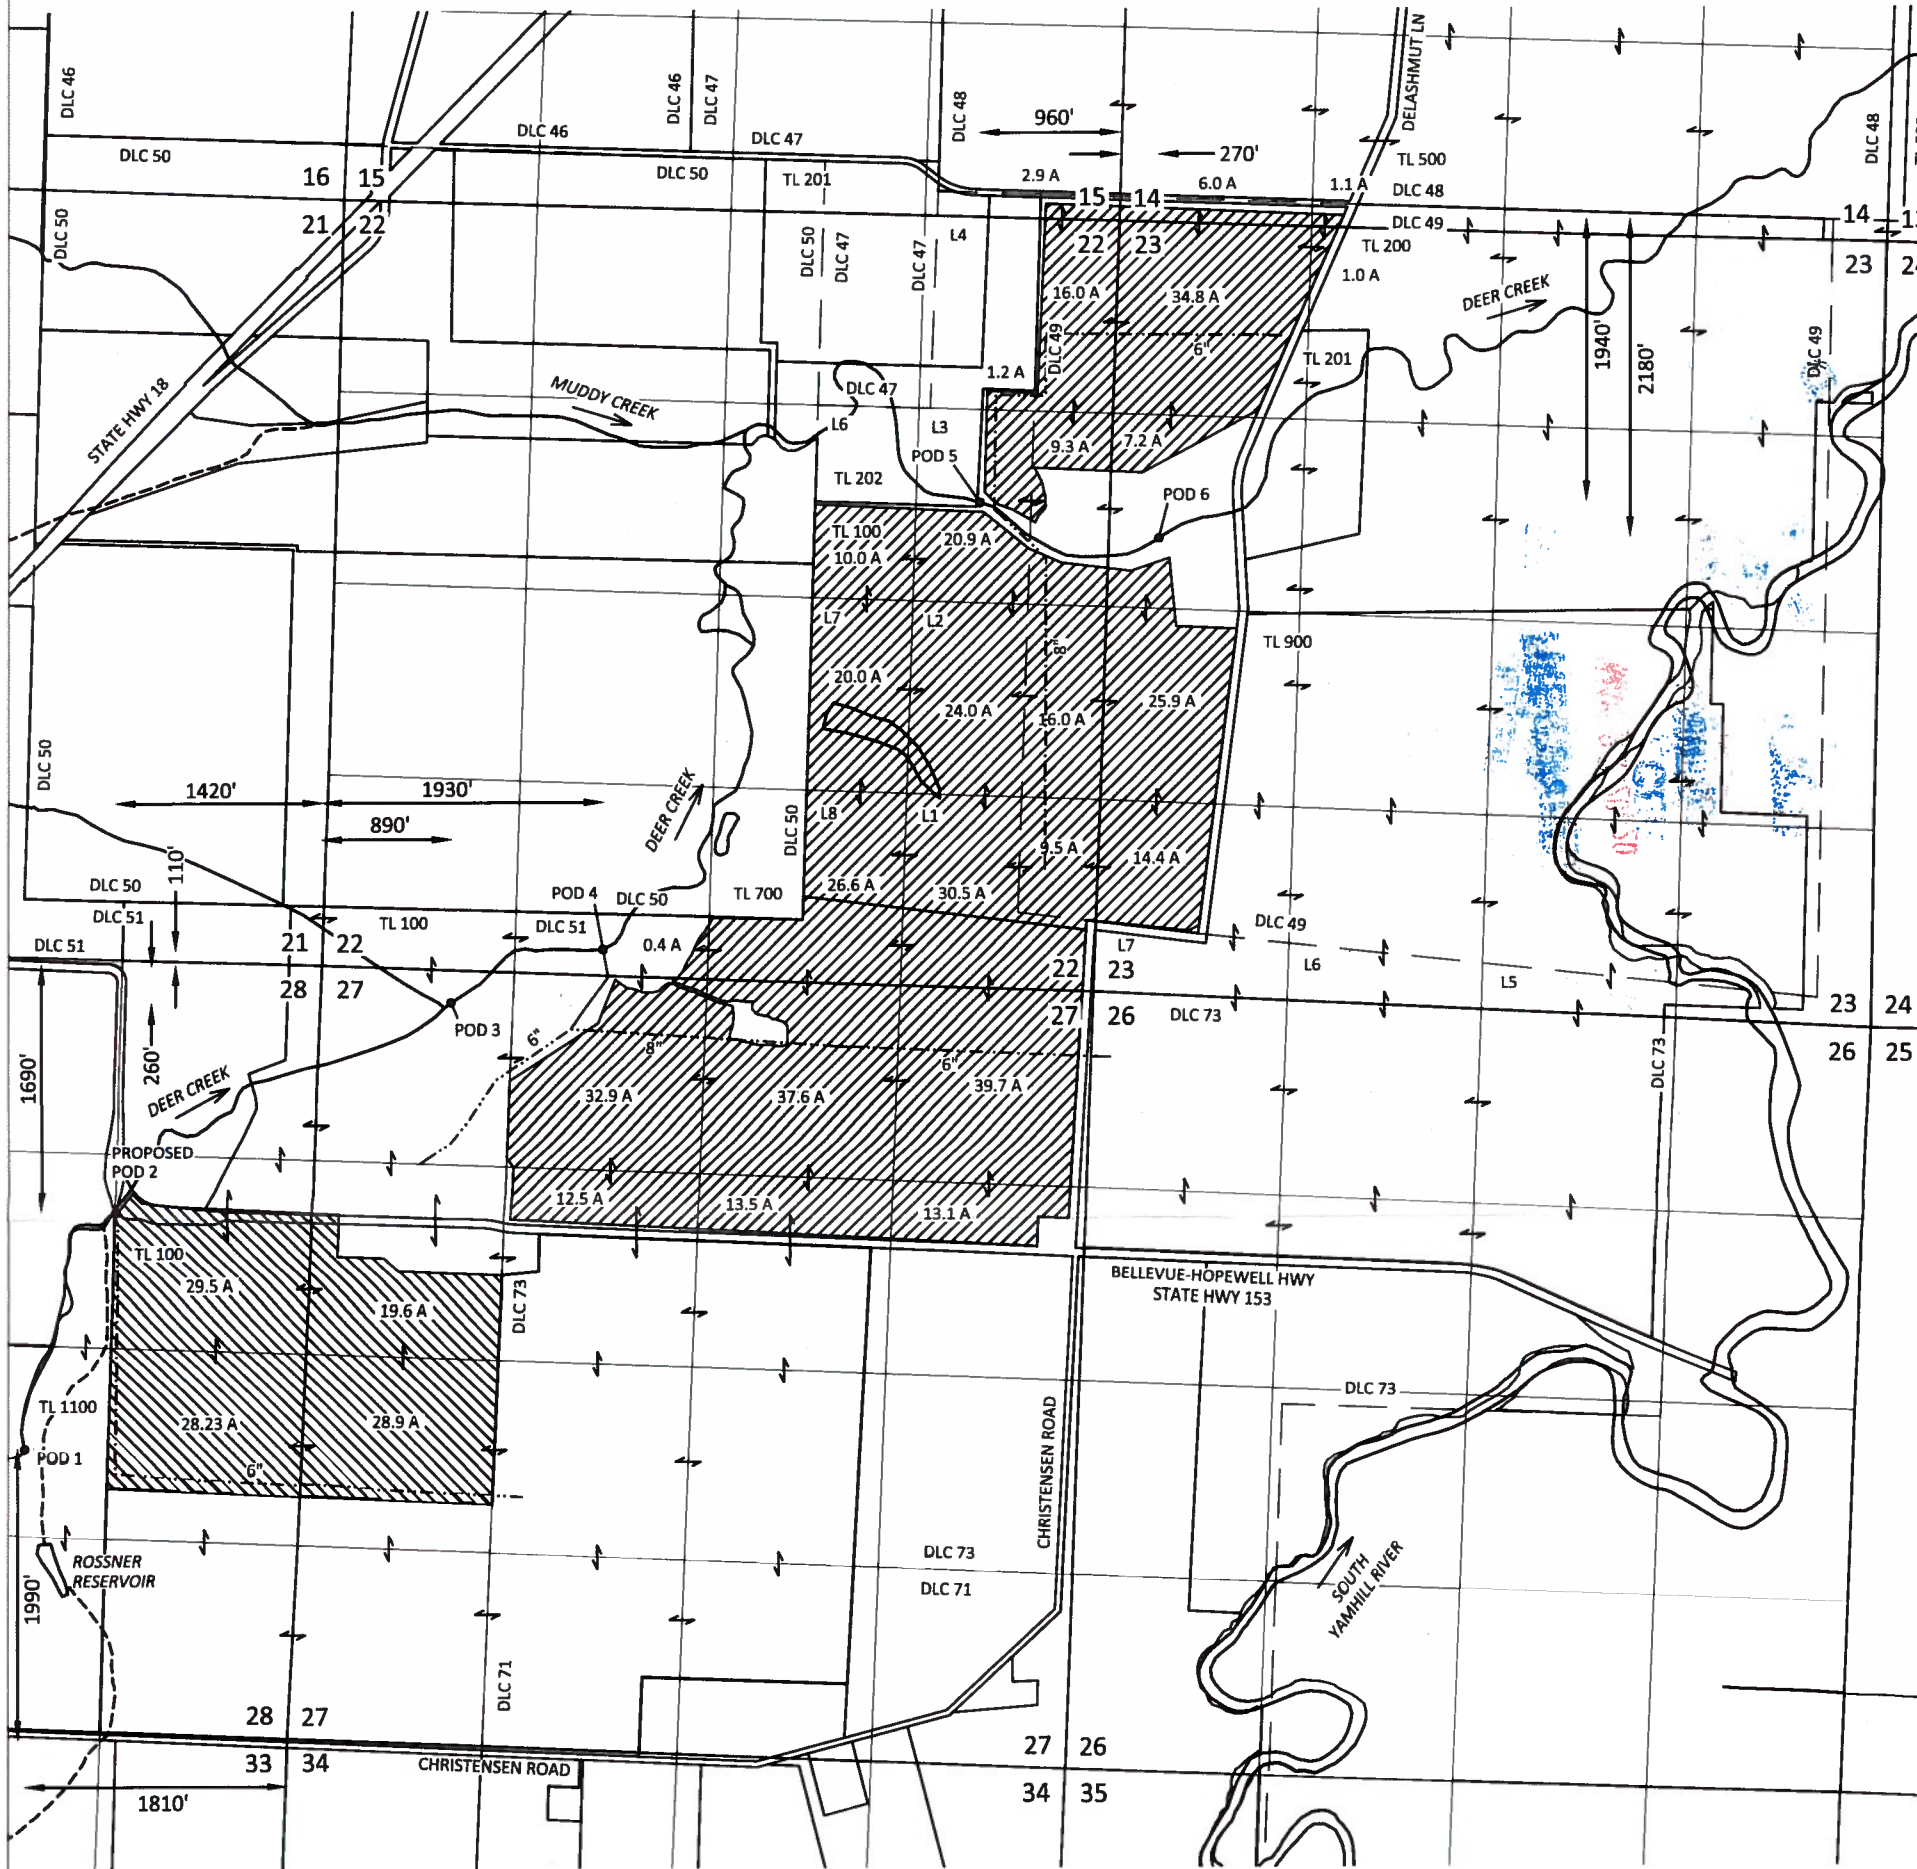


Sections 14, 15, 21, 22, 23, 27 & 28, T5S, R5W, W.M., Yamhill County, Oregon

TRANSFER APPLICATION MAP
Certificate 22691
K.A. Berger Farms Inc.



EXPLANATION

-  427.0 ACRES OF IRRIGATION FROM PODS 3, 4 AND 5 UNCHANGED PRIORITY: 3/19/1951
-  106.23 ACRES OF IRRIGATION FROM POD 2 PRIORITY: 3/19/1951
-  POINT OF DIVERSION (POD)


NOTE: POD 1 IS NOT CHANGING AND CAN BE USED TO IRRIGATE THE SAME ACRES AS POD 2

CERTIFIED WATER RIGHT EXAMINER
439
Steven R. Bruce
STEVEN R. BRUCE
JUNE 13, 1997
STATE OF OREGON
Expires 12/31/2021

RECEIVED

MAY 22 2020

OWRD

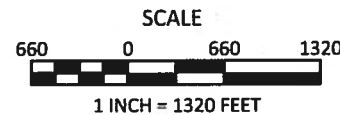

May 18, 2020

This map is not intended to provide legal dimensions or locations of property ownership lines

Figure 1

SKOOKUM
WATER ASSOCIATES INC

1626 VICTORIAN WAY
EUGENE, OR 97401
(503) 319-8926