


Claim of Beneficial Use T-13077

A Water Right in the Name of Oregon Department of Transportation for Oak Grove Rest Area

Linn County, Oregon
Township 15 South, Range 3 West (W.M.)

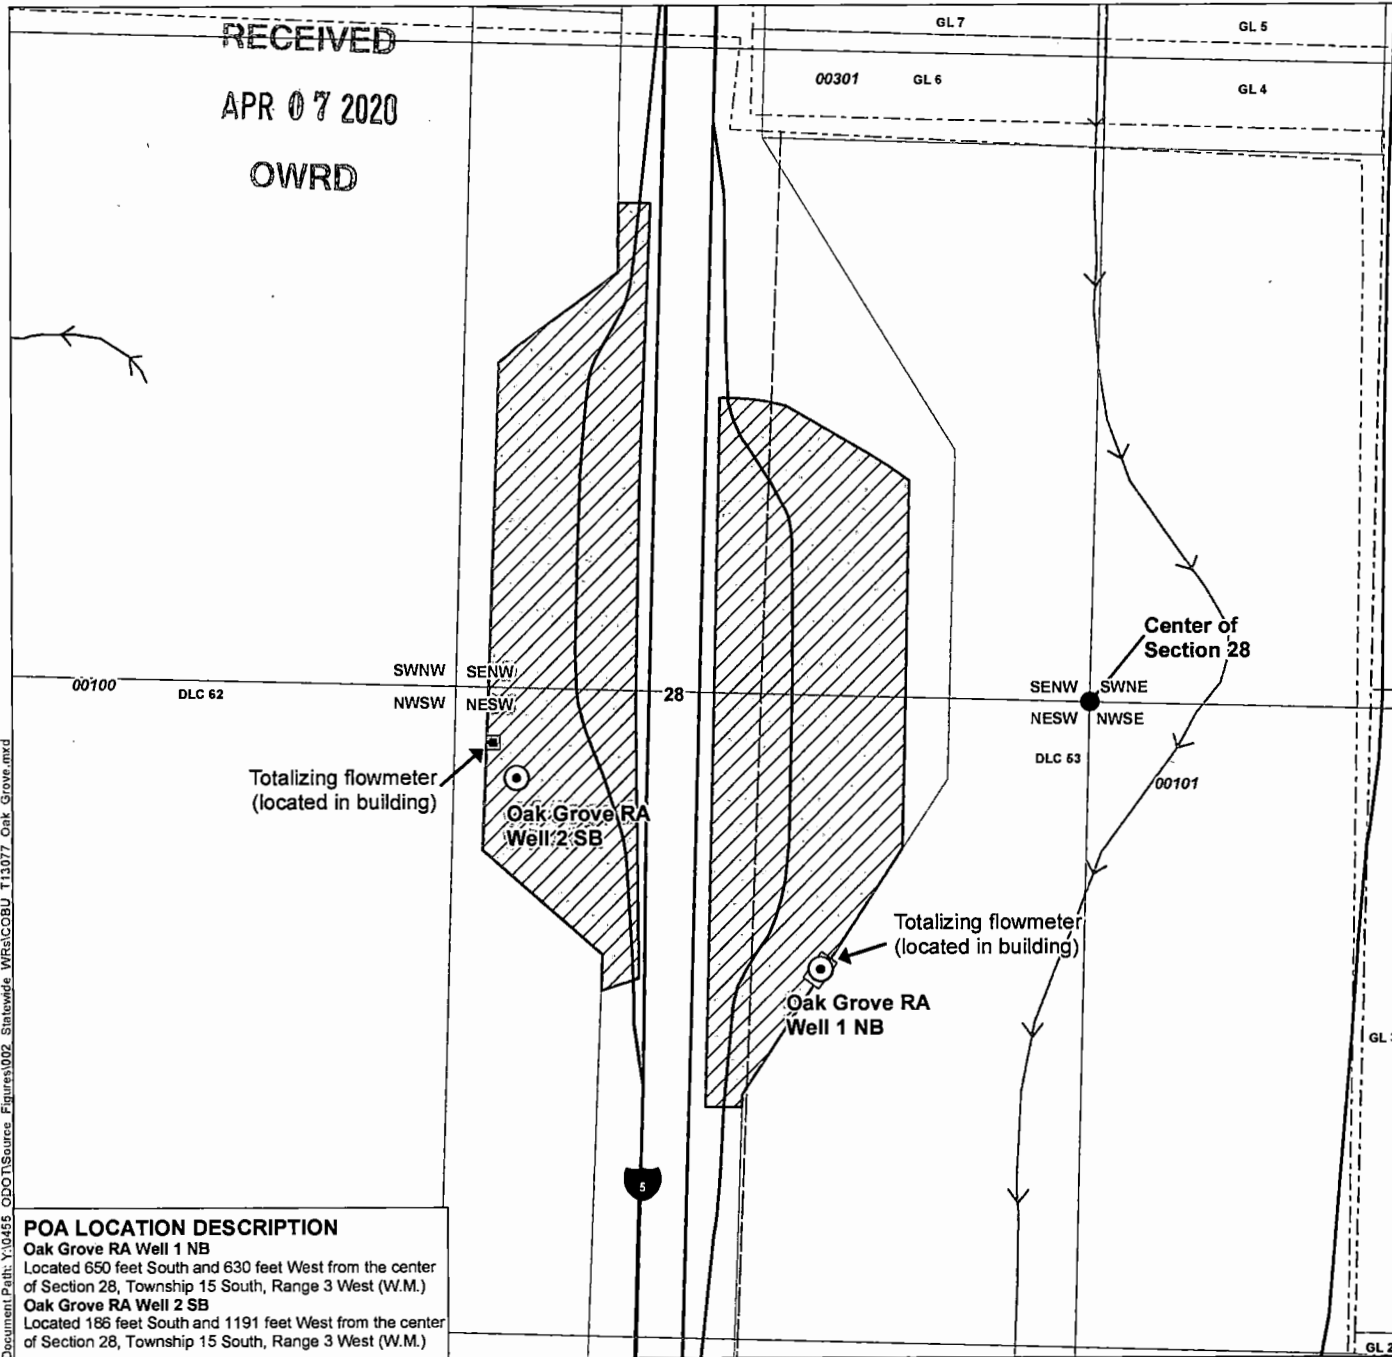

Document Path: Y:\0455 ODOT\Source Figures\002 Statewide WRS\COBU T13077 Oak Grove.mxd

POA LOCATION DESCRIPTION
Oak Grove RA Well 1 NB
 Located 650 feet South and 630 feet West from the center of Section 28, Township 15 South, Range 3 West (W.M.)
Oak Grove RA Well 2 SB
 Located 186 feet South and 1191 feet West from the center of Section 28, Township 15 South, Range 3 West (W.M.)

- LEGEND**
- Point of Appropriation (POA)
 - Place of Use (POU)
 - Building
 - Government Lot (GL) Donation
 - Land Claim (DLC)
 - All Other Features**
 - Tax Lot
 - Major Road
 - Watercourse (with flow arrows)

Certified Water Rights Examiner Stamp

CERTIFIED WATER RIGHTS EXAMINER
 #94217CWRE

 ROBYN C. COOK
 MAY 16, 2019
 STATE OF OREGON
 RENEWS: 12/31/2021

DISCLAIMER
 This map was prepared for the purpose of identifying the location of a water right only and it is not intended to provide legal dimensions or location of property ownership lines.

MAP NOTES
 Date: March 20, 2020
 Data Sources: OGIC, ESRI, OWRD, Linn Co., USGS
 00100 = Tax Lot Number