

**Claim of Beneficial Use Map  
Permit G-17729  
Application G-11833,  
Water Right in the  
Name of City of Woodburn  
Marion County, Oregon  
Township 5 South,  
Range 1, 2 West (W.M)**

**LEGEND**

- ⊙ Point of Appropriation (POA)
- Water Main
- Place of Use (POU) (within UGB)
- All Other Features
  - Tax Lot
  - ▭ Urban Growth Boundary
  - ▭ Donation Land Claim (DLC)
  - Railroad
  - Major Road
  - Watercourse
  - Waterbody


RECEIVED  
APR 17 2020  
OWRD

**POA LOCATION DESCRIPTION**

- Well 7**  
-Located 2000 feet South and 540 feet East from the NW corner of Section 12, Township 5 South, Range 2 West (W.M.)  
-Tax Lot: 0100  
-Flowmeter installed at wellhead.
- Well 9**  
-Located 1200 feet South and 1980 feet East from the NW corner of Section 7, Township 5 South, Range 1 West (W.M.)  
-Tax Lot: 0600  
-Flowmeter installed at wellhead.
- Well 10**  
-Located 1200 feet North and 1720 feet West from the E 1/4 corner of Section 8, Township 5 South, Range 1 West (W.M.)  
-Tax Lot: 2000  
-Flowmeter installed at wellhead.
- Well 11**  
-Located 1840 feet South and 920 feet East from the NW corner of Section 7, Township 5 South, Range 1 West (W.M.)  
-Tax Lot: 1400  
-Flowmeter installed at wellhead.
- Well 12**  
-Located 2466 feet North and 1635 feet West from the SE corner of Section 13, Township 5 South, Range 2 West (W.M.)  
-Tax Lot: 0600  
-Flowmeter installed at wellhead.
- Well 13**  
-Located 1415 feet South and 1155 feet East from the NW corner of Section 18, Township 5 South, Range 1 West (W.M.)  
-Tax Lot: 4100  
-Flowmeter installed at wellhead.
- Well 14**  
-Located 1117 feet North and 35 feet West from the SE corner of Section 5, Township 5 South, Range 1 West (W.M.)  
-Tax Lot: 3101  
-Flowmeter installed at wellhead.

**DISCLAIMER**

This map was prepared for the purpose of identifying the location of a water right only and it is not intended to provide legal dimensions or location of property ownership lines.

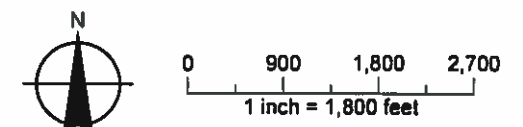

Date: April 7, 2020  
Data Sources: BLM, Marion Co., USGS, ESRI

Certified Water Rights Examiner Stamp

THEODORE R. RESZLER  
JUNE 29, 2007  
STATE OF OREGON  
RENEWS: 12-31-2020