


T21S, R29E, W.M.  
Harney County, Oregon

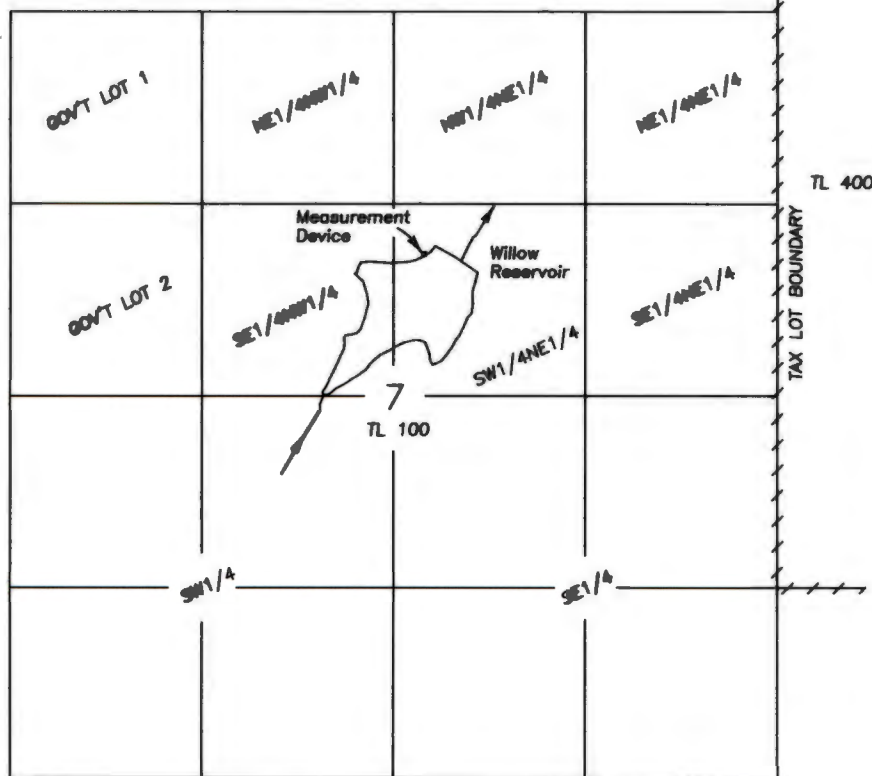

SCALE 1"=1320'

Outlet is located 1690' S & 2420' W of the  
NE corner of Section 7.  
Measurement device is located 105' N & 68" E of the outlet.

FINAL PROOF SURVEY  
CLAIM OF BENEFICIAL USE  
WILLOW RESERVOIR

For

Bureau of Land Management  
September 13, 2016

LEGEND

Application No. R-69348  
Permit No. R-12115  
Priority 12/31/1991

A portion of Tax Lot  
21-29 TL100

NOTE: Tax Lot 100 is owned by the BLM  
and is more that 19,000 acres.  
Therefore only a portion of the tax  
lot boundary can be shown.

Prepared by  
Cornerstone Surveying, Inc  
P.O. BOX 33  
JOHN DAY, OR. 97845  
(541)575-1813  
cornerstonesurvey@centurytel.net

NOTE: The preparation of this map  
was for the purpose of identifying  
the location of the proposed water  
right and has no intent to provide  
dimensions or location of property  
ownership lines.

RECEIVED BY OWRD

NOV 14 2016

SALEM, OR

