


T21S, R29E, W.M.  
Harney County, Oregon

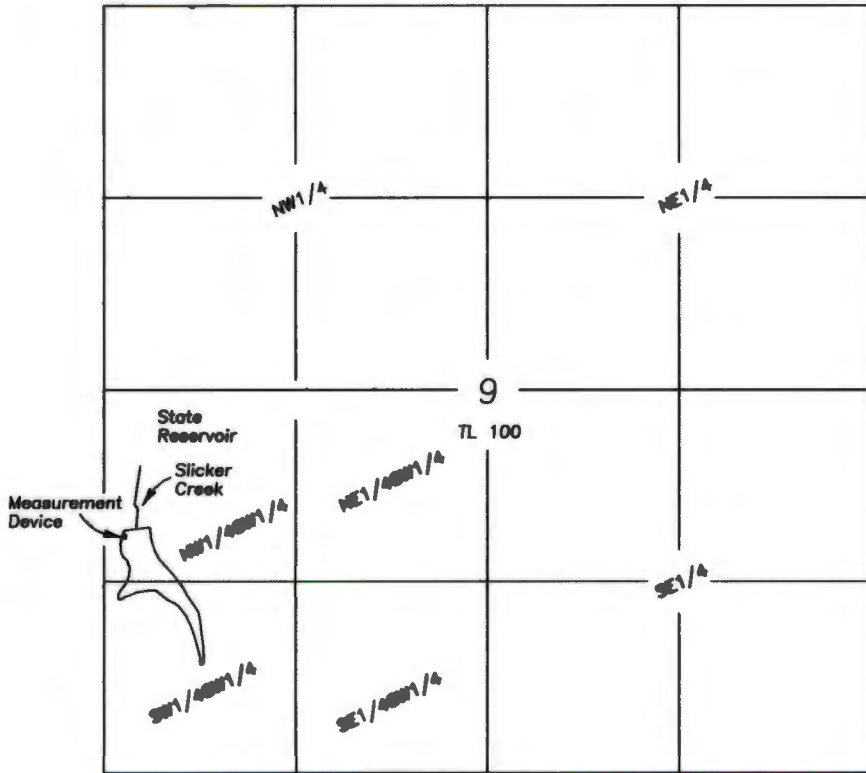

SCALE 1"=1320'

Outlet is located 1620' N & 130' E of the SW corner of Section 9.  
Measuring device is located 5' S and 11' E of the Outlet

FINAL PROOF SURVEY  
CLAIM OF BENEFICIAL USE  
STATE RESERVOIR

For  
Bureau of Land Management  
September 15, 2016

LEGEND

Application No. R-69349  
Permit No. R-11903  
Priority 12/31/1991

A portion of Tax Lot  
21-29 TL100

NOTE: Tax Lot 100 is owned by the BLM  
and is more that 19,000 acres.  
No tax lot boundaries can be shown.

Prepared by  
Cornerstone Surveying, Inc  
P.O. BOX 33  
JOHN DAY, OR. 97845  
(541)575-1813  
cornerstonesurvey@centurytel.net

NOTE: The preparation of this map  
was for the purpose of identifying  
the location of the proposed water  
right and has no intent to provide  
dimensions or location of property  
ownership lines.

RECEIVED BY OWRD

NOV 14 2016

SALEM, OR

