


T. 22S., R20E & 21E, W.M.

RECEIVED BY OWRD

DEC 12 2014

SALEM, OR

Scale  
1" = 1320'  
(4" = 1 mile)

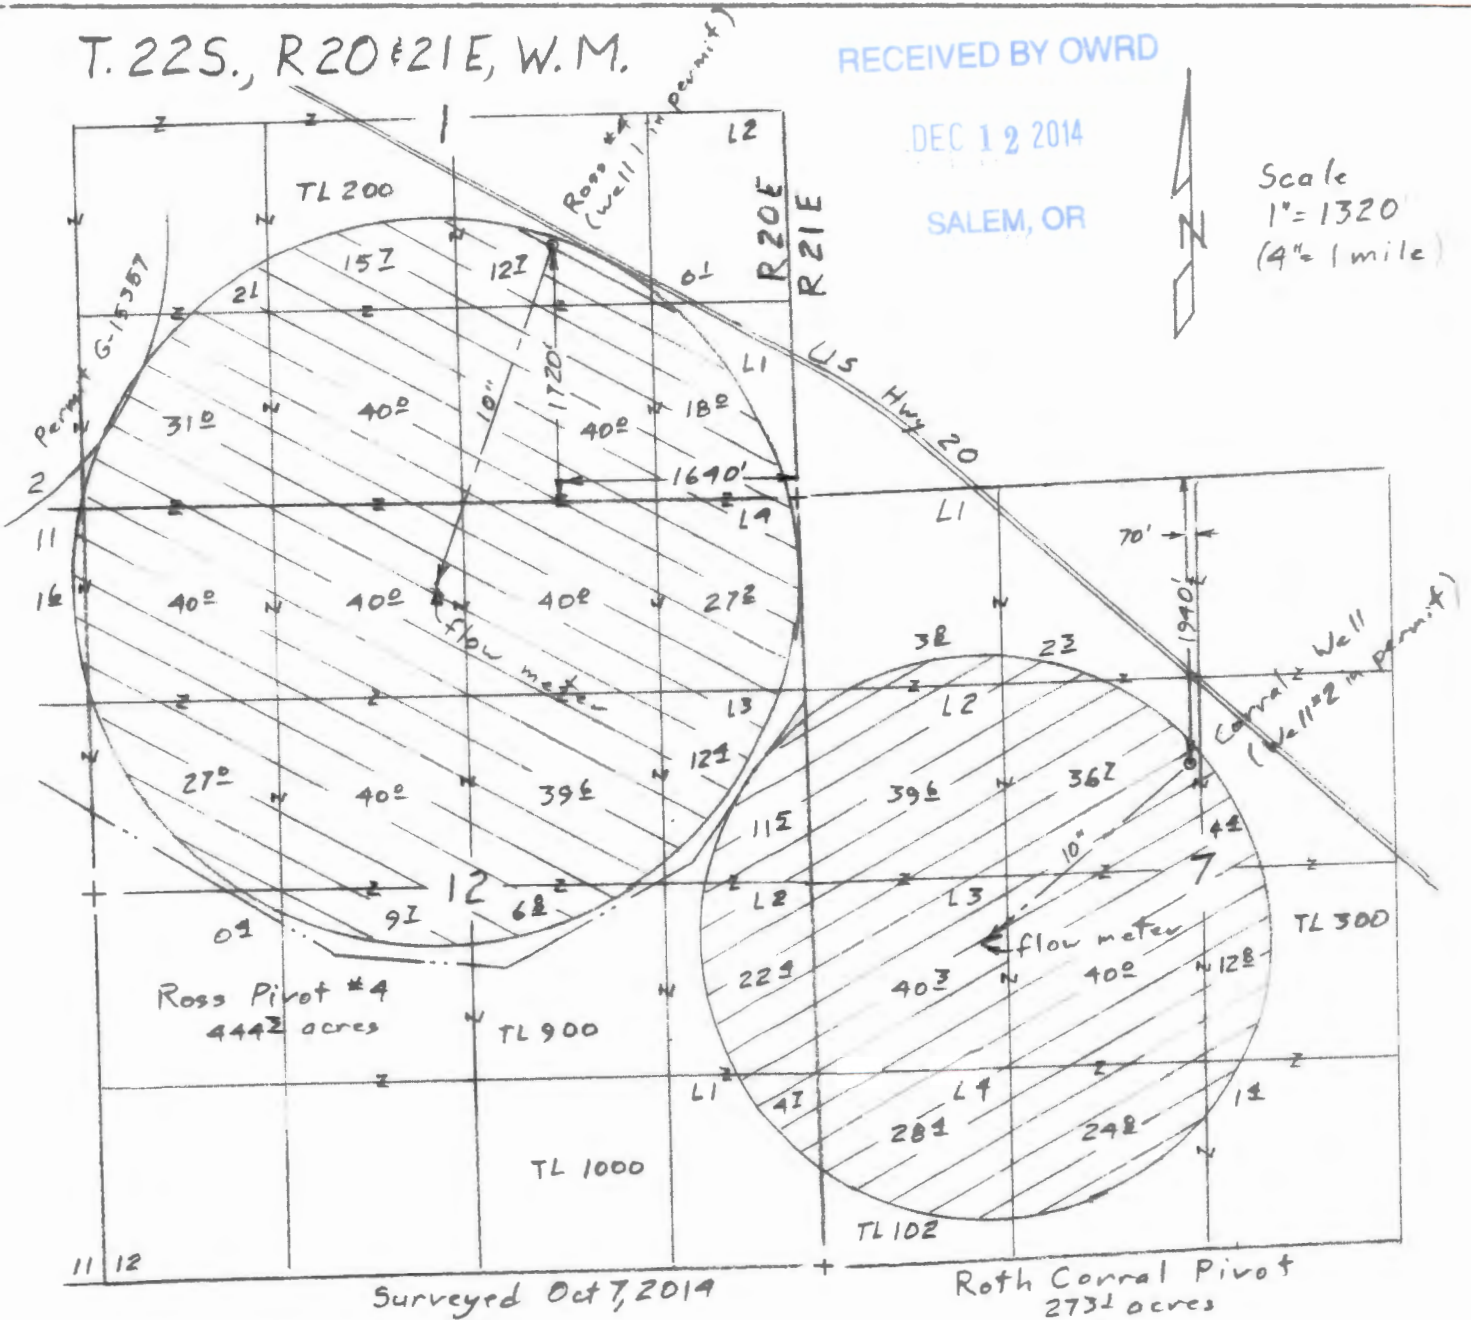

Surveyed Oct 7, 2014

Roth Corral Pivot  
2731 acres

App G-16123

Per G-15706

Claim of Beneficial Use Map  
for

Robert Ross & Stephen Roth



This map is for the purpose of locating a water right only and has no intent to provide legal dimensions or the location of property lines.

**ESTES SURVEYS, LLC**

PO Box 17519  
Salem, OR 97306-7519  
(503) 585-7583

60382 Arnold Rd  
Bend, OR 97702  
(541) 382-7391