
## FINAL PROOF SURVEY

UNDER
APPLICATION NO. 70439
PERMIT NO. 51213

IN THE NAME OF BURL JAMES OR JOSEPHINE M. EASTMAN SURVEYED OCTOBER 23, 1991 BY J. EDWARD HENRICKS SCALE 1"=1320'-0"

SECTION 10 T.10S.,R.2W.,W.M. LINN COUNTY, OREGON

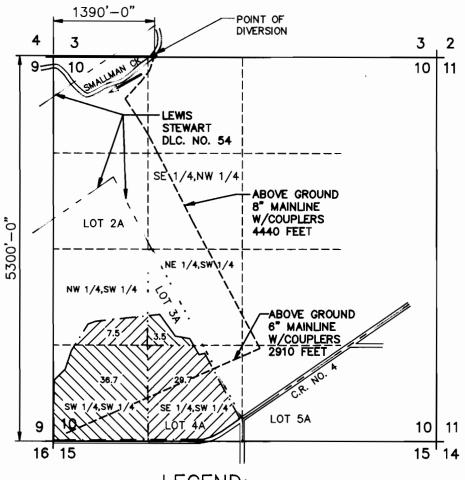



LEGEND:

SECTION LINES

– PROPERTY LINE – ABOVE GROUND MAINLINE

DONATION LAND

CLAIM LINE LOT LINE

I J. EDWARD HENRICKS, BEING DULY SWORN AS A WATER RIGHT EXAMINER LICENSE NO. 170 HAVE PREPARED THIS MAP FOR BURL JAMES AND JOSEPHINE M. EASTMAN ON THIS 23rd DAY OF OCTOBER, 1991. THE AREAS CROSS HATCHED REPRESENT THE ACREAGES TO BE IRRIGATED BY THIS WATER RIGHT.

PREPARATION OF THIS MAP IS FOR THE PURPOSE OF IDENTIFYING THE LOCATION OF THE WATER RIGHT ONLY AND HAS NO INTENT TO PROVIDE DIMENSIONS OR LOCATION OF PROPERTY OWNERSHIP LINES.

ONLY FOCUMENTS STAMPED WITH RED INK ARE ORIGINALS

