

CLAIM OF BENEFICIAL USE MAP


TO CHANGE PLACE OF USE AND POINT OF APPROPRIATION
FOR APPLICATION T-12211

RECEIVED

APR 30 2020

OWRD

NORTH 1/2 OF SECTION 27,
TOWNSHIP 27 SOUTH, RANGE 16 EAST, W.M.
TAX LOTS: 100, 200, 300, AND 500

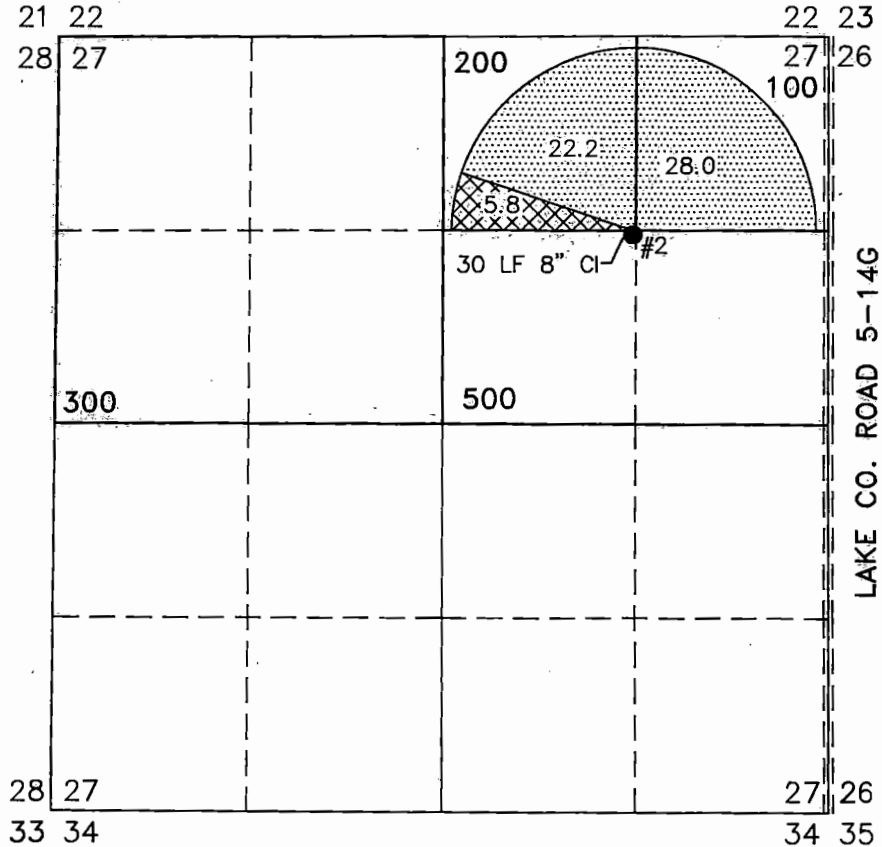

5.8 AC IR FROM C76941
(TRANSFER T-12211)



50.2 AC IR FROM C52875
(TRANSFER T-12211)

THIS MAP IS FOR THE PURPOSE OF LOCATING A WATER RIGHT
ONLY AND HAS NO INTENT TO PROVIDE LEGAL DIMENSIONS OR
THE LOCATION OF PROPERTY LINES

POA 2 (LAKE 50565)

LOCATED IN THE SW 1/4 NE 1/4 SECTION 27, T27S
R16E, W.M. AND 1352.7 FEET SOUTH AND 1332.4 FEET
WEST FROM THE NE CORNER OF SECTION 27. FLOW
METER LOCATED 10 FEET NORTH ON DELIVERY PIPE.



RENEWAL DATE: 12/31/2020

PREPARED FOR:

DOUBLE J RANCH, LLC
P.O. BOX 766
CHRISTMAS VALLEY, OR 97641

PREPARED BY:



ALL POINTS ENGINEERING AND SURVEYING, INC.
P.O. BOX 767 TERREBONNE, OR 97760
(541) 548-5833 www.APEandS.com