


# Claim of Beneficial Use

TRANSFER T-10387

TOWNSHIP 26 S., RANGE 6 W., W.M.

DOUGLAS COUNTY, OREGON

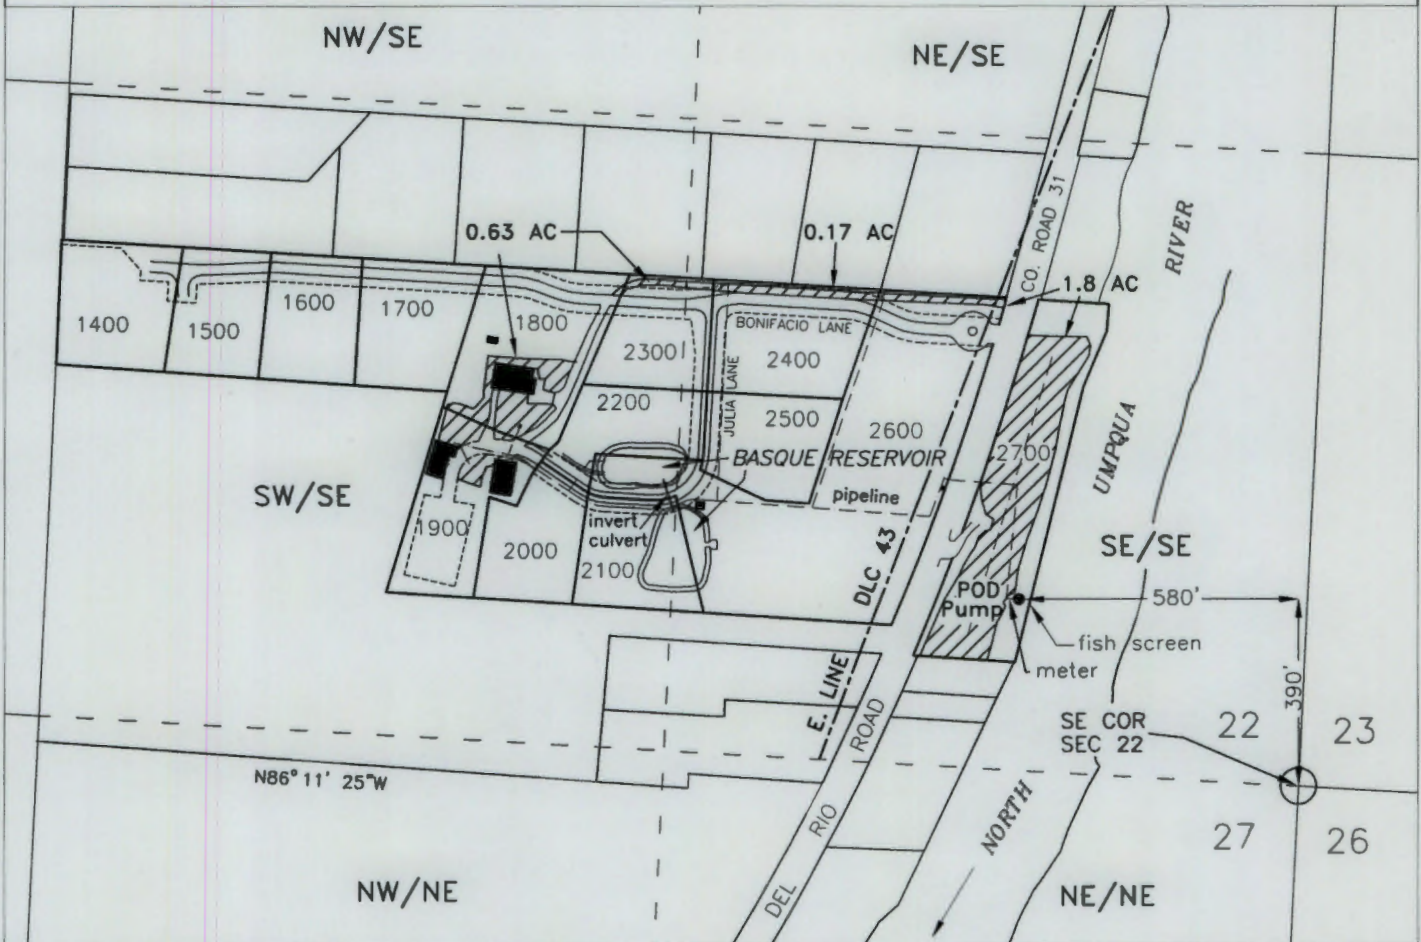

## LEGEND

- Irrigation - 2.6 Acres

Mainline

Buildings

Base GIS map provided by i.e. Engineering and adjusted to subdivision map vol.22 page 49A over 7/15/2015 Google aerial photo & Oregon Map aerial photo (11/28/2016) for assumed best fit

PREPARED FOR:  
BASCO BROS. LLC  
P.O. BOX 131  
WINCHESTER, OR 97495



This map is not intended to provide legal dimensions or locations of property ownership lines

Assessor Map #  
T-26S, R6W-22D

RECEIVED BY OWRD

OCT 04 2017

SALEM, OR

NORTH

JORDAN ENGINEERING  
460 JORDAN LANE  
ROSEBURG, OREGON 97471  
(541) 673-1931

12/14/2016 n.e.d.