

POD LOCATION DESCRIPTION
 Willamette POD: Located 1650 feet South and 1000 feet East from NW Corner of Section 26 Township 9 South, Range 4 West (W.M.)
 Point of Re-Diversion: Located 238 feet South and 663 feet West from the NE Corner of DLC 54 (NENW), Township 9 South, Range 4 West (W.M.)


LEGEND

Mainlines	All Other Features
Place of Use (POU)	Tax Lot
Donation Land Claim (DLC)	Watercourse
Government Lot (GL)	Waterbody

DISCLAIMER
 This map was prepared for the purpose of identifying the location of a water right only and it is not intended to provide legal dimensions or location of property ownership lines.

MAP NOTES
 Date June 11, 2019
 Data Sources: BLM, USGS, Polk County

RECEIVED
JUN 13 2019
OWRD

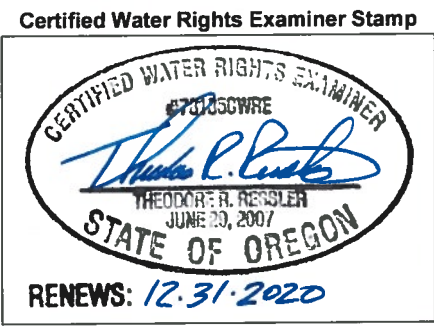

Claim of Beneficial Use for Permit S-54819 (Application S-87894)
A Water Right in the Name of VFO Independence, LLC
 Polk County, Oregon
 Township 9 South, Range 4 West (W.M.)

