


T. 30 S., R 4 W., W.M.

SCALE: 1" = 400'

THE PURPOSE OF THIS MAP IS TO IDENTIFY THE LOCATION OF THE WATER RIGHT. IT IS NOT INTENDED TO PROVIDE INFORMATION RELATIVE TO THE LOCATION OF PROPERTY OWNERSHIP BOUNDARY LINES.

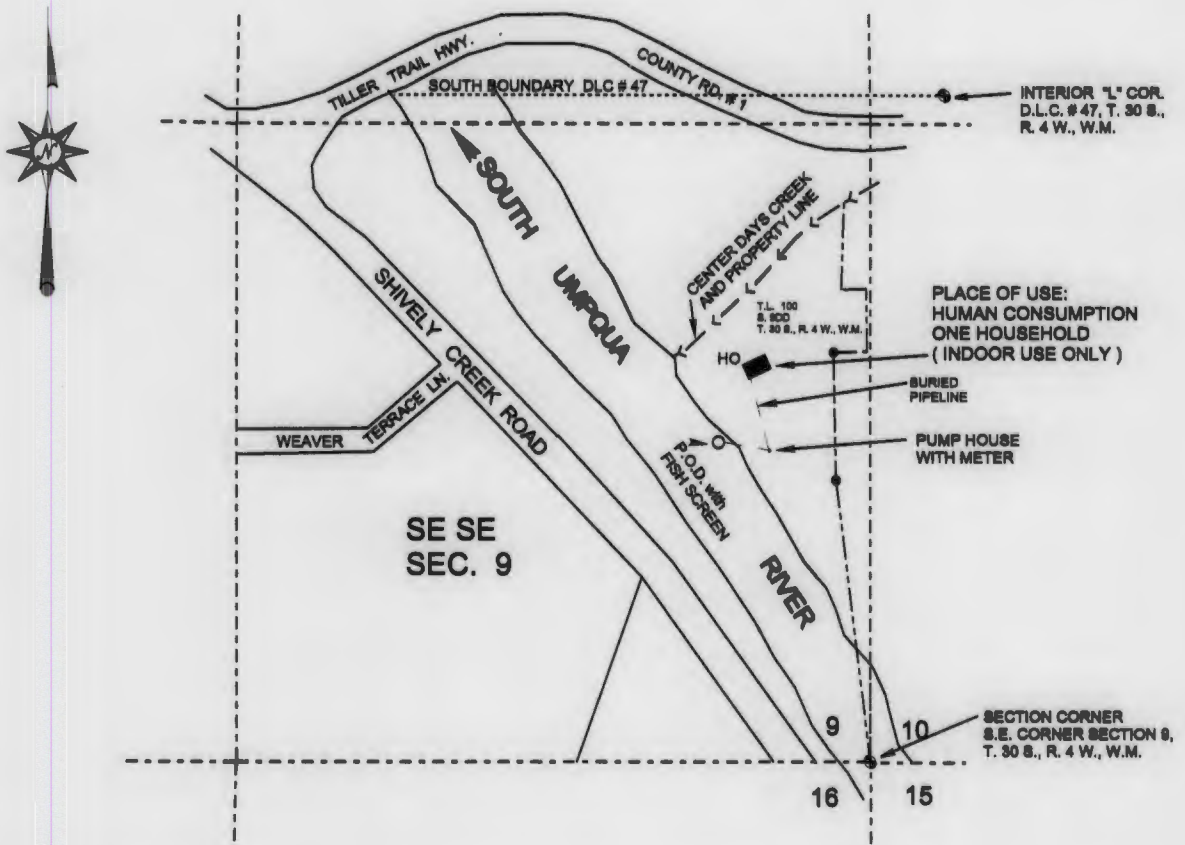

POD IS 661 FEET NORTH AND 316 FEET WEST OF THE SOUTHEAST SECTION CORNER OF SECTION 9, TOWNSHIP 30 SOUTH, RANGE 4 WEST, WILLAMETTE MERIDIAN. METER BEARS SOUTH 81° 39' 36" EAST 107 FEET FROM POD.

FINAL PROOF SURVEY

UNDER

Application No. S-87880 Permit No. S-54877

LEGEND

- POINT OF DIVERSION
- FD. MONUMENT PER SURVEY M 173-61
- COMPUTED SEC. CORNER PER SURVEY M 173-61, UNLESS OTHERWISE NOTED.
- PROPERTY LINES PER M 173-61
- - - - - 40 LINES

IN NAME OF

CHARLES PRITCHARD

Surveyd: JAN. 02, 2019 by: R.F. BROWN



RENEWS 12/31/2019

RECEIVED

APR 17 2019

OWRD