

**CLAIM OF BENEFICIAL USE MAP**  
 FOR: GERALD FRENCH  
 BY: NATHAN R. REED, PE, CWRE  
 T26S, R3W, W.M. SECTION 16, DLC 41  
 APPLICATION NO. S-88483  
 PERMIT NO. S-55153



Scale: 1" = 400'

DATE SURVEYED: FEBRUARY 5, 2019




RECEIVED  
 FEB 21 2019  
 OWRD

POD IS LOCATED 800 FEET SOUTH AND 840 FEET EAST FROM NW CORNER OF SECTION 16.

**Legend**

- |  |            |  |            |  |           |
|--|------------|--|------------|--|-----------|
|  | Stream     |  | Driveway   |  | Section   |
|  | Flow arrow |  | Structures |  | Quarter   |
|  | POD        |  | Gov Lot    |  | Sixteenth |
|  | Pipeline   |  | DLC        |  | Parcels   |

MAP PREPARED FOR:  
 GERALD FRENCH  
 741 LONE ROCK ROAD  
 GLIDE, OR 97443

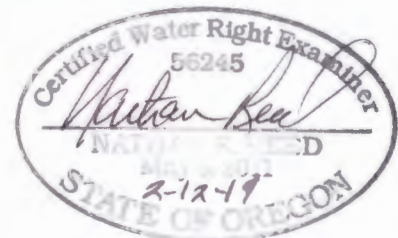

Expires Dec. 31, 2020

THE PURPOSE OF THIS MAP IS TO IDENTIFY THE LOCATION OF THE WATER RIGHT. IT IS NOT INTENDED TO PROVIDE INFORMATION RELATIVE TO THE LOCATION OF PROPERTY OWNERSHIP BOUNDARY LINES.

MAP PREPARED BY:  
 NATHAN R. REED, PE, CWRE  
 157 W. BODIE ST  
 ROSEBURG, OR 97471