









**Final Proof Survey Map
for Blatchford
for Permit G-16104
Township 8 South, Range 39 East (W.M.)
Baker County, Oregon**



LEGEND

-  Well 5 - with Flowmeter
-  Pipelines
-  Primary
-  Supplemental
-  Tax Lots
-  Highways
-  Watercourse
-  Waterbody

Well Location Description

Well 5
Located 50 feet North and 1,280 feet East from the W1/4 corner of Section 10, Township 8 South, Range 39 East (W.M.)

Certified Water Rights Examiner Stamp

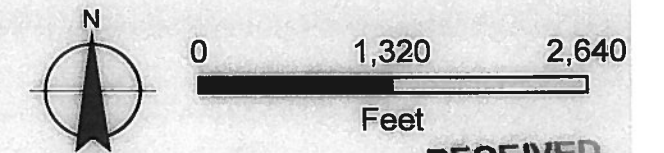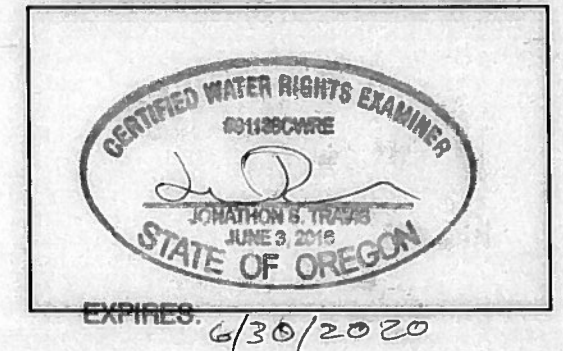

RECEIVED

JUL 19 2018


OWRD

Disclaimer

This map was prepared for the purpose of identifying the location of a water right only and it is not intended to provide legal dimensions or location of property ownership lines.

Map Notes

Date: 4/20/2018
Data Sources: ESRI, BLM, USGS
Prepared By: GeoEngineers

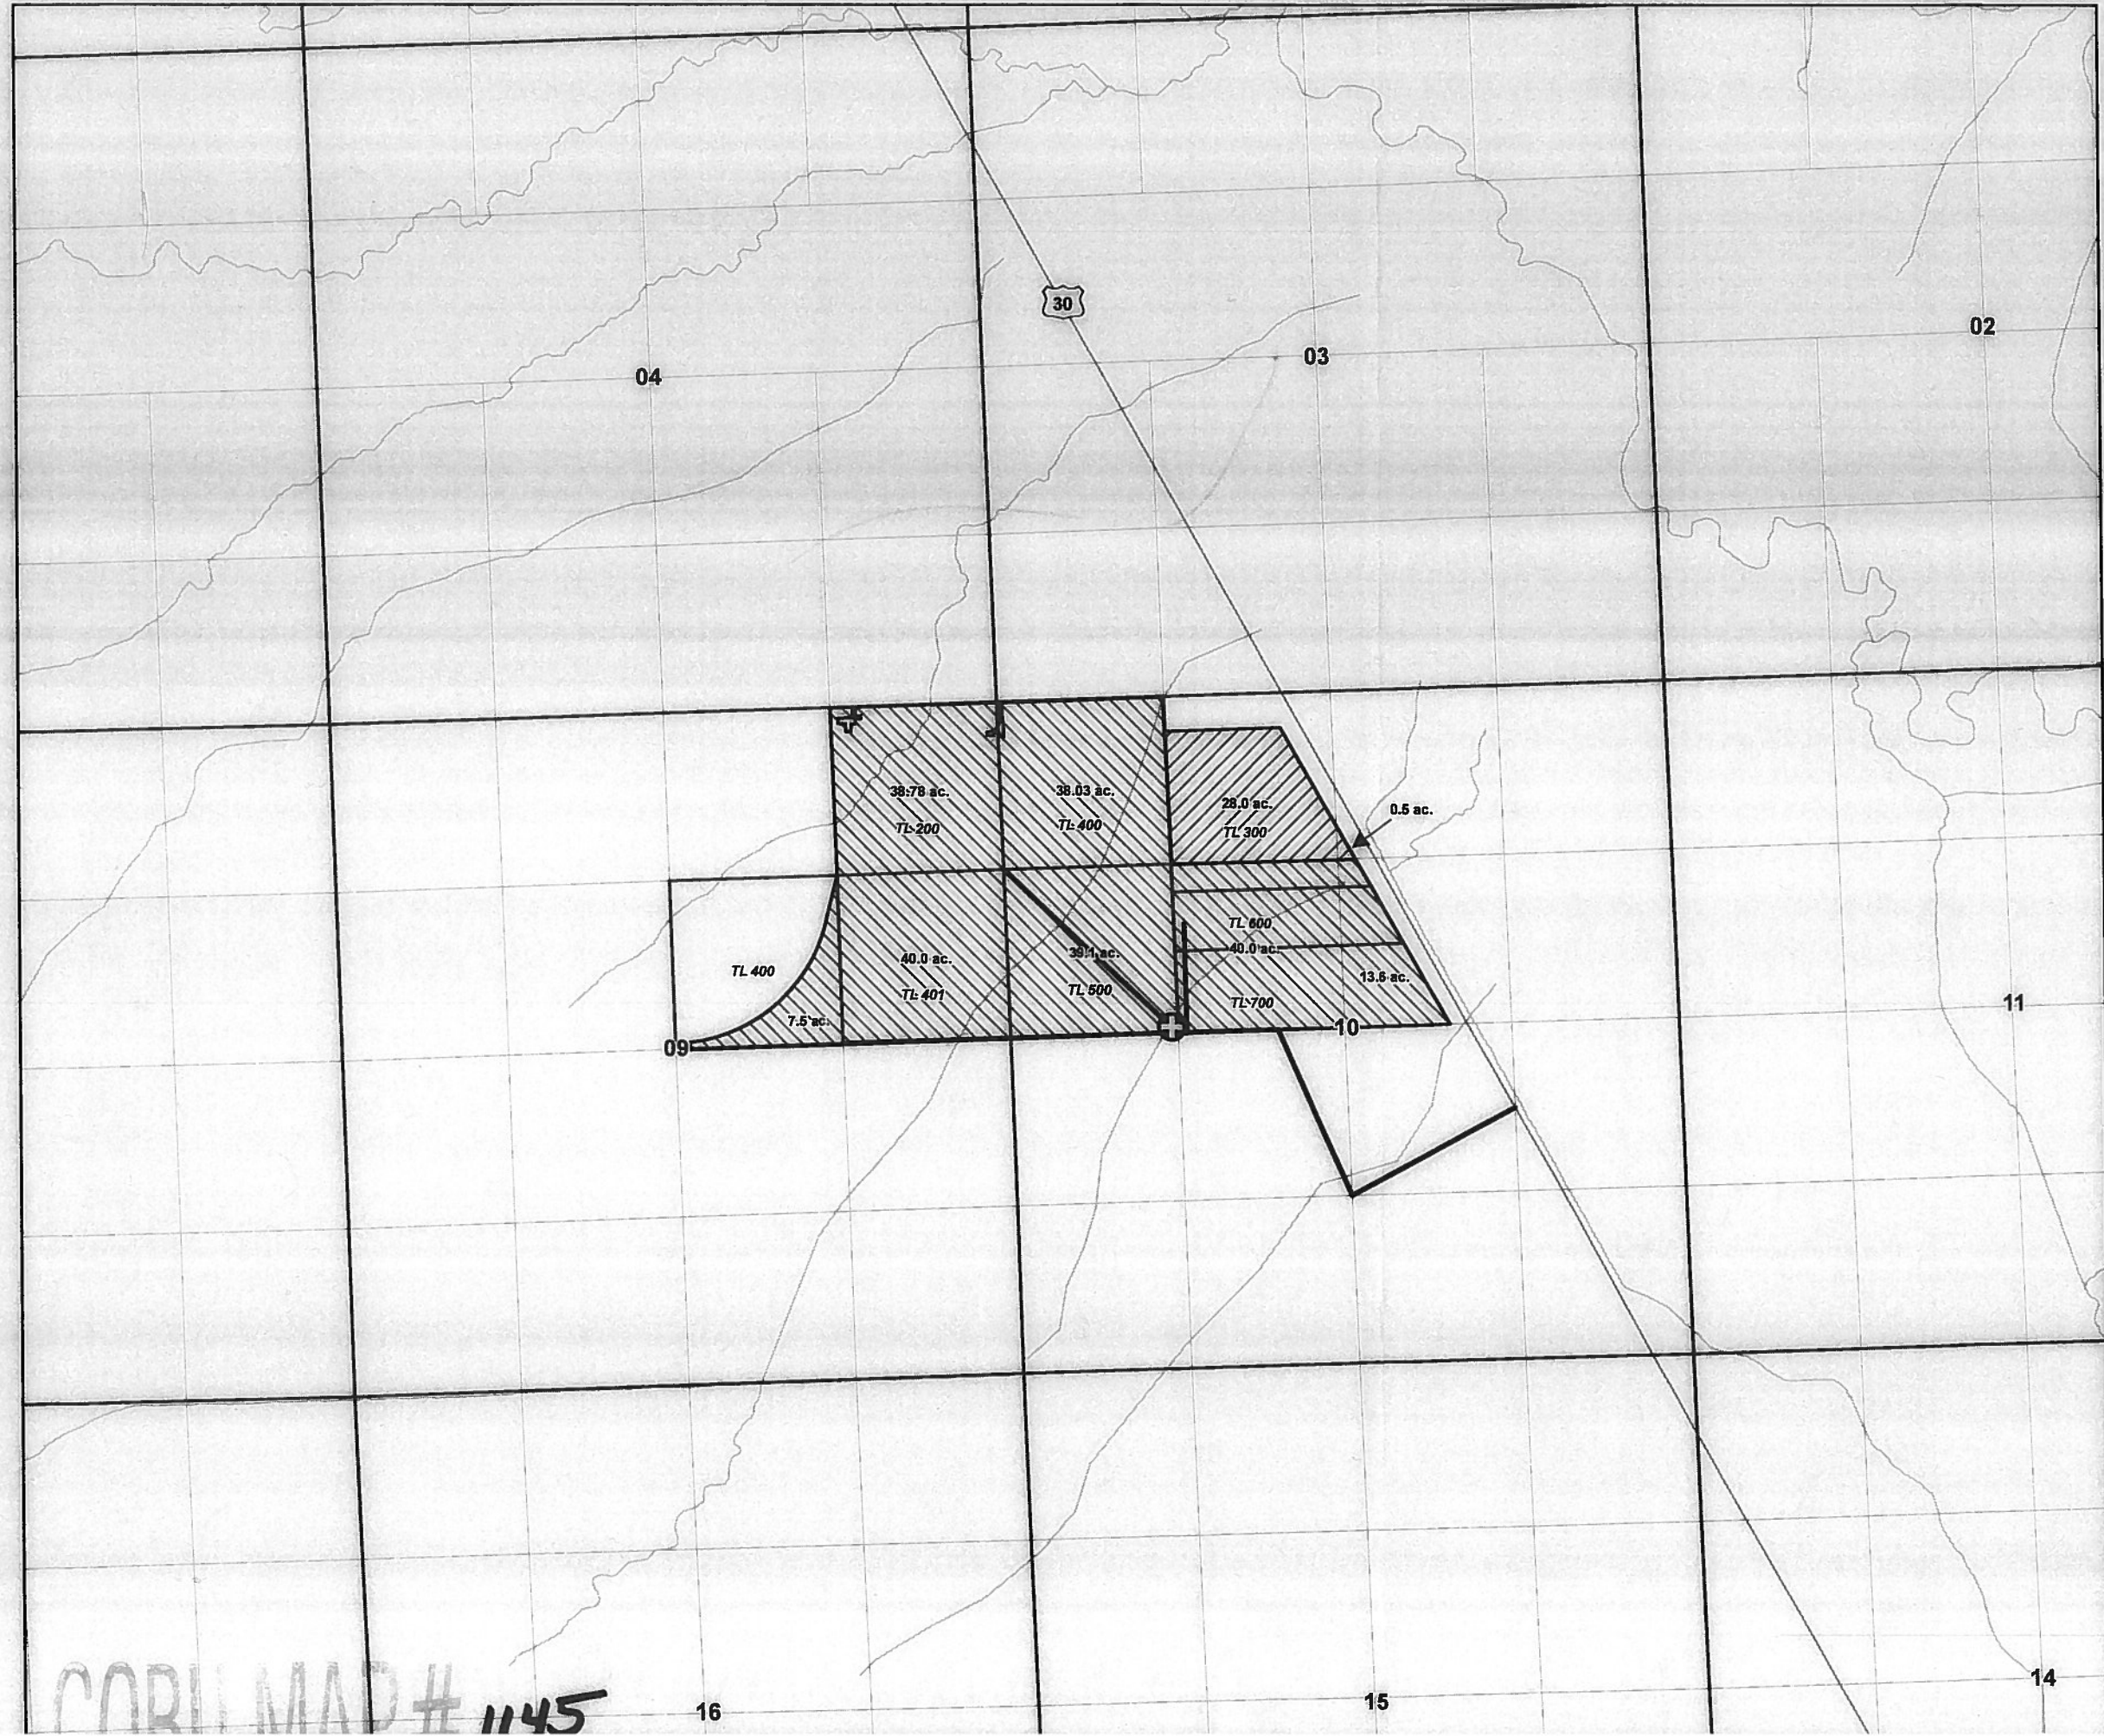

CORRECTION # 1145