


Claim of Beneficial Use Map Permit R-15282, Application R-88426

Water Right in the Name of Coquille Indian Tribe
Township 27 South, Range 14 West, Section 4 (W.M.)

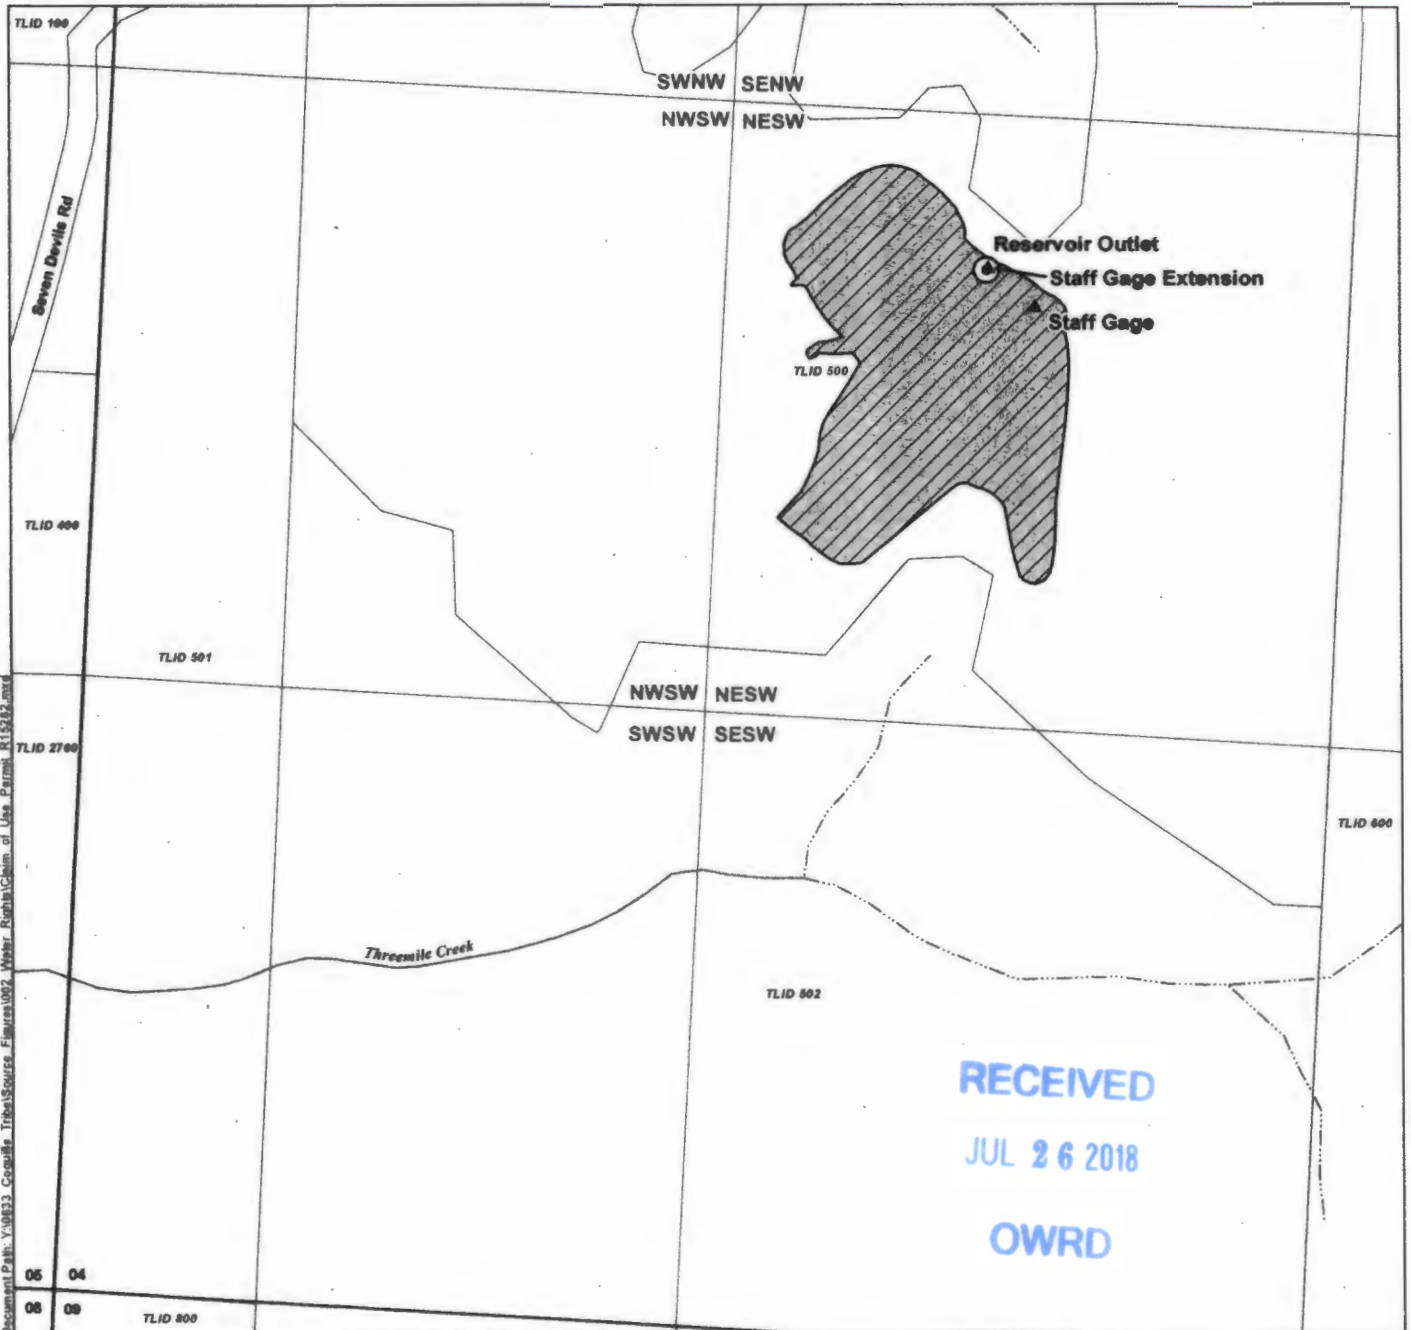

Document Path: Y:\0633_Coquille_Tribal\Source_E\mrcs\002_Water_Rights\Claim_of_Use_Permit_R15282.mxd

LEGEND

- ▲ Staff Gage
- ⊙ Place of Diversion (POD)
- ▨ Place of Use (POU)
- Tax Lot
- ~ Watercourse, Perennial
- - - Watercourse, Intermittent
- ☪ Waterbody

POD LOCATION DESCRIPTION
Reservoir Outlet
Located 2,260 feet North and 1,880 feet East from the SW corner of Section 4, Township 27 South, Range 14 West (W.M.)

Certified Water Rights Examiner Stamp



DISCLAIMER

This map was prepared for the purpose of identifying the location of a water right only and it is not intended to provide legal dimensions or location of property ownership lines.

MAP NOTES

Date: July 12, 2018
Data Sources: BLM, USGS, Coos Co, ESRI

