



T8S, R45E, Section 2, Willamette Meridian

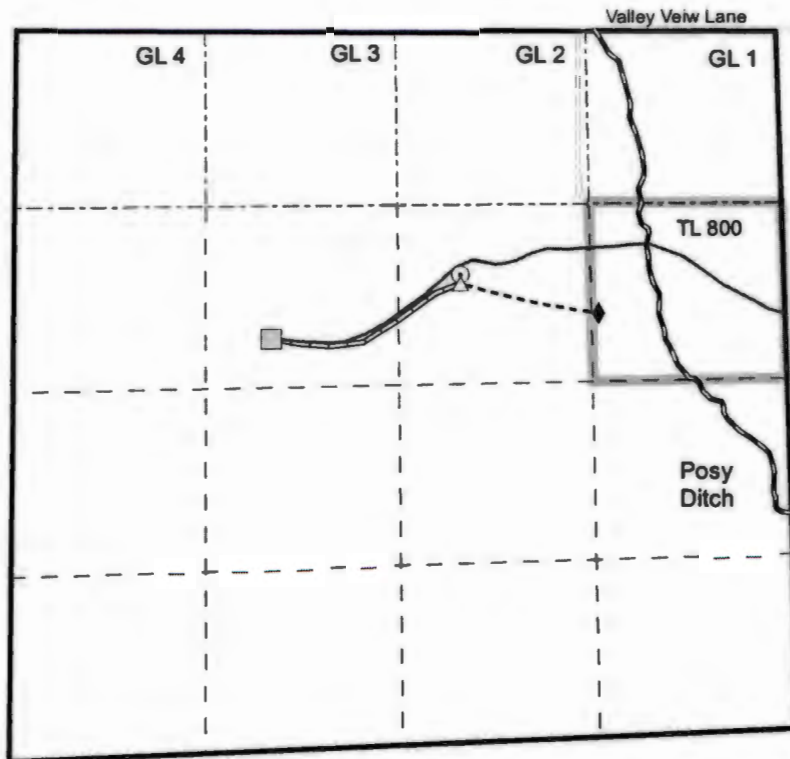

RECEIVED
OCT 12 2018
OWRD

- POD
- △ Cistern
- ⊙ Cistern overflow & measuring point
- ◆ Spigot
- 1.5-inch plastic pipe
- ===== 2.25-inch plastic pipe
- Ditch
- Road
- Unnamed stream
- Government lot line
- - - - Quarter quarter line
- Section line
- Tax lot

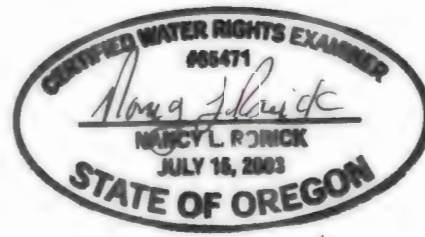

Expires 12/31/2018

The POD is located in the SE NW, Section 2, T18S, R45E, W.M.; 2136 feet south and 450 feet west from N 1/4 Section 2.

This map is not intended to provide legal dimensions or locations of property ownership lines.

Final Proof Map
Application S84585 and Permit S54081
Tax Lot 800, Baker County

Prepared for Barbara and Mark Lauer

Prepared by Nancy Rorick Consulting

