


SECTION 3, T.9S., R.27E., W.M.

RECEIVED

AUG 02 2019

OWRD

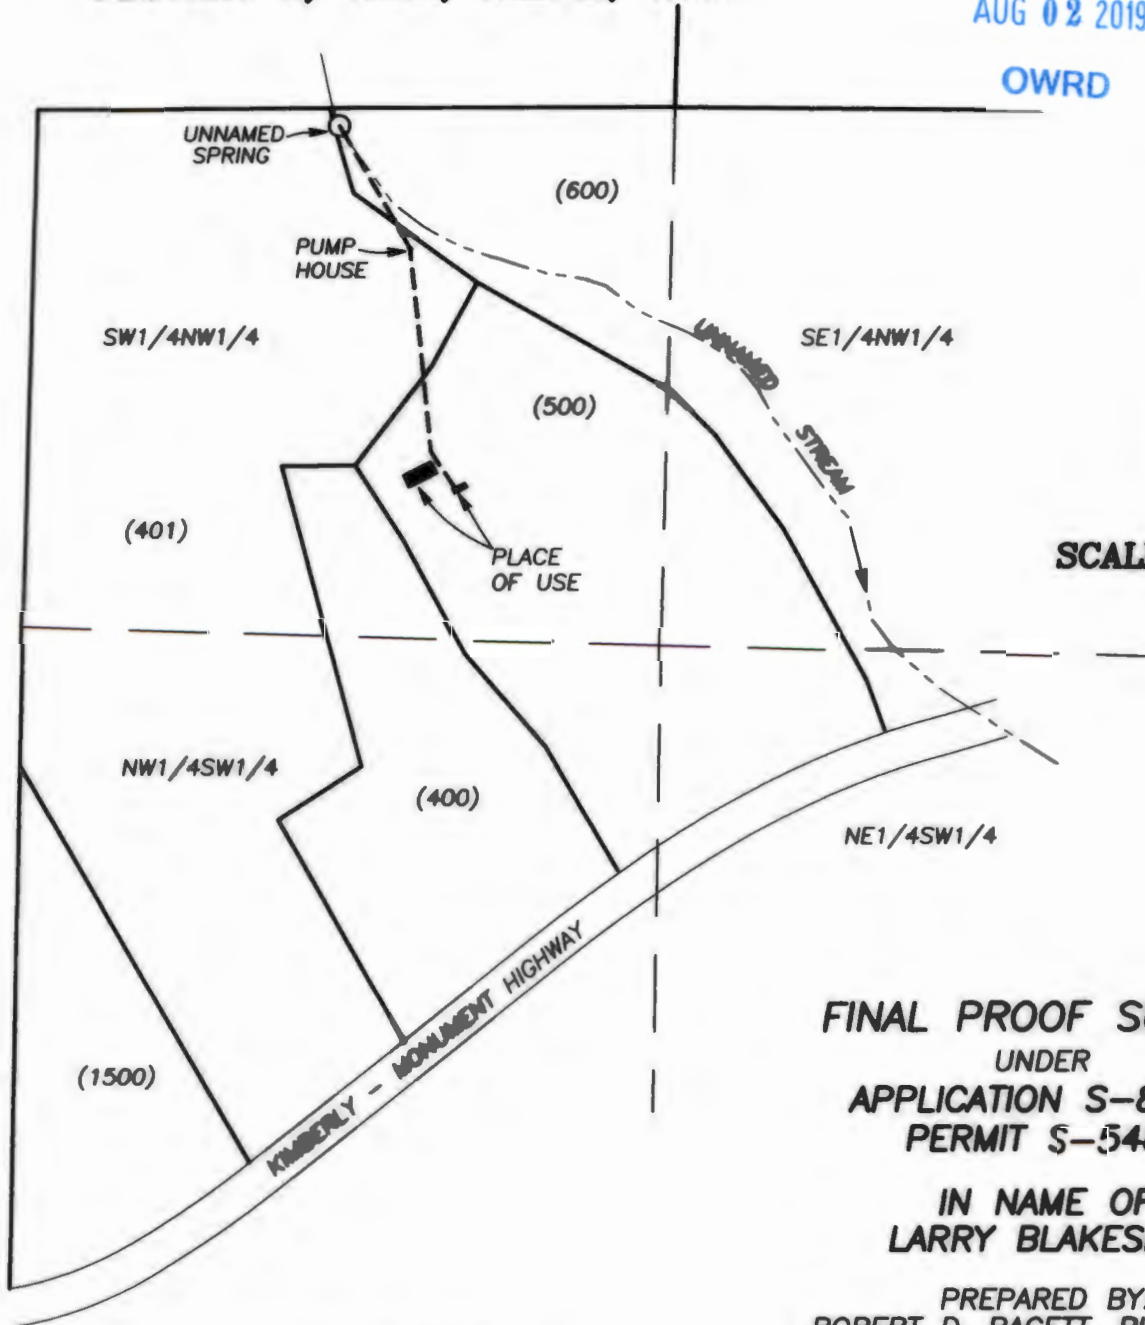

SCALE: 1" = 400'

FINAL PROOF SURVEY
 UNDER
APPLICATION S-87629
PERMIT S-5487
 IN NAME OF
LARRY BLAKESLEE

PREPARED BY:
 ROBERT D. BAGETT, PLS, CWRE
 217 N. CANYON BLVD.
 JOHN DAY, OREGON
 (541) 575-1251

JUNE 12, 2019


○ POD SOURCE: UNNAMED SPRING
 930 FT. SOUTH & 650 FT. EAST OF
 CLOSING CORNER MONUMENT BETWEEN
 SECTIONS 3 & 4, T.9S., R.27E.

FLOWMETER IN PUMP HOUSE BEARS
 S.29°48'E., 295.0 FT. FROM POD

--- BURIED PIPELINE

() TAX LOT NO.

NOTE: FOUND BRASS CAPPED IRON PIPE AT
 CLOSING CORNER MONUMENT BETWEEN
 SECTIONS 3 & 4, T.9S., R.27E.

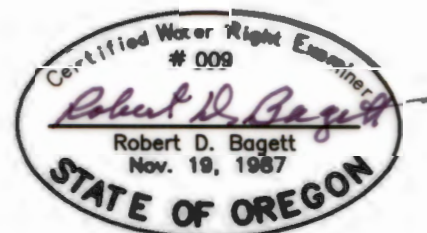

RENEWS: 12/31/2019

DISCLAIMER: THIS MAP IS NOT INTENDED TO PROVIDE LEGAL
 DIMENSIONS OR LOCATIONS OF PROPERTY BOUNDARY LINES.