


ownship 4 South Range 12 East

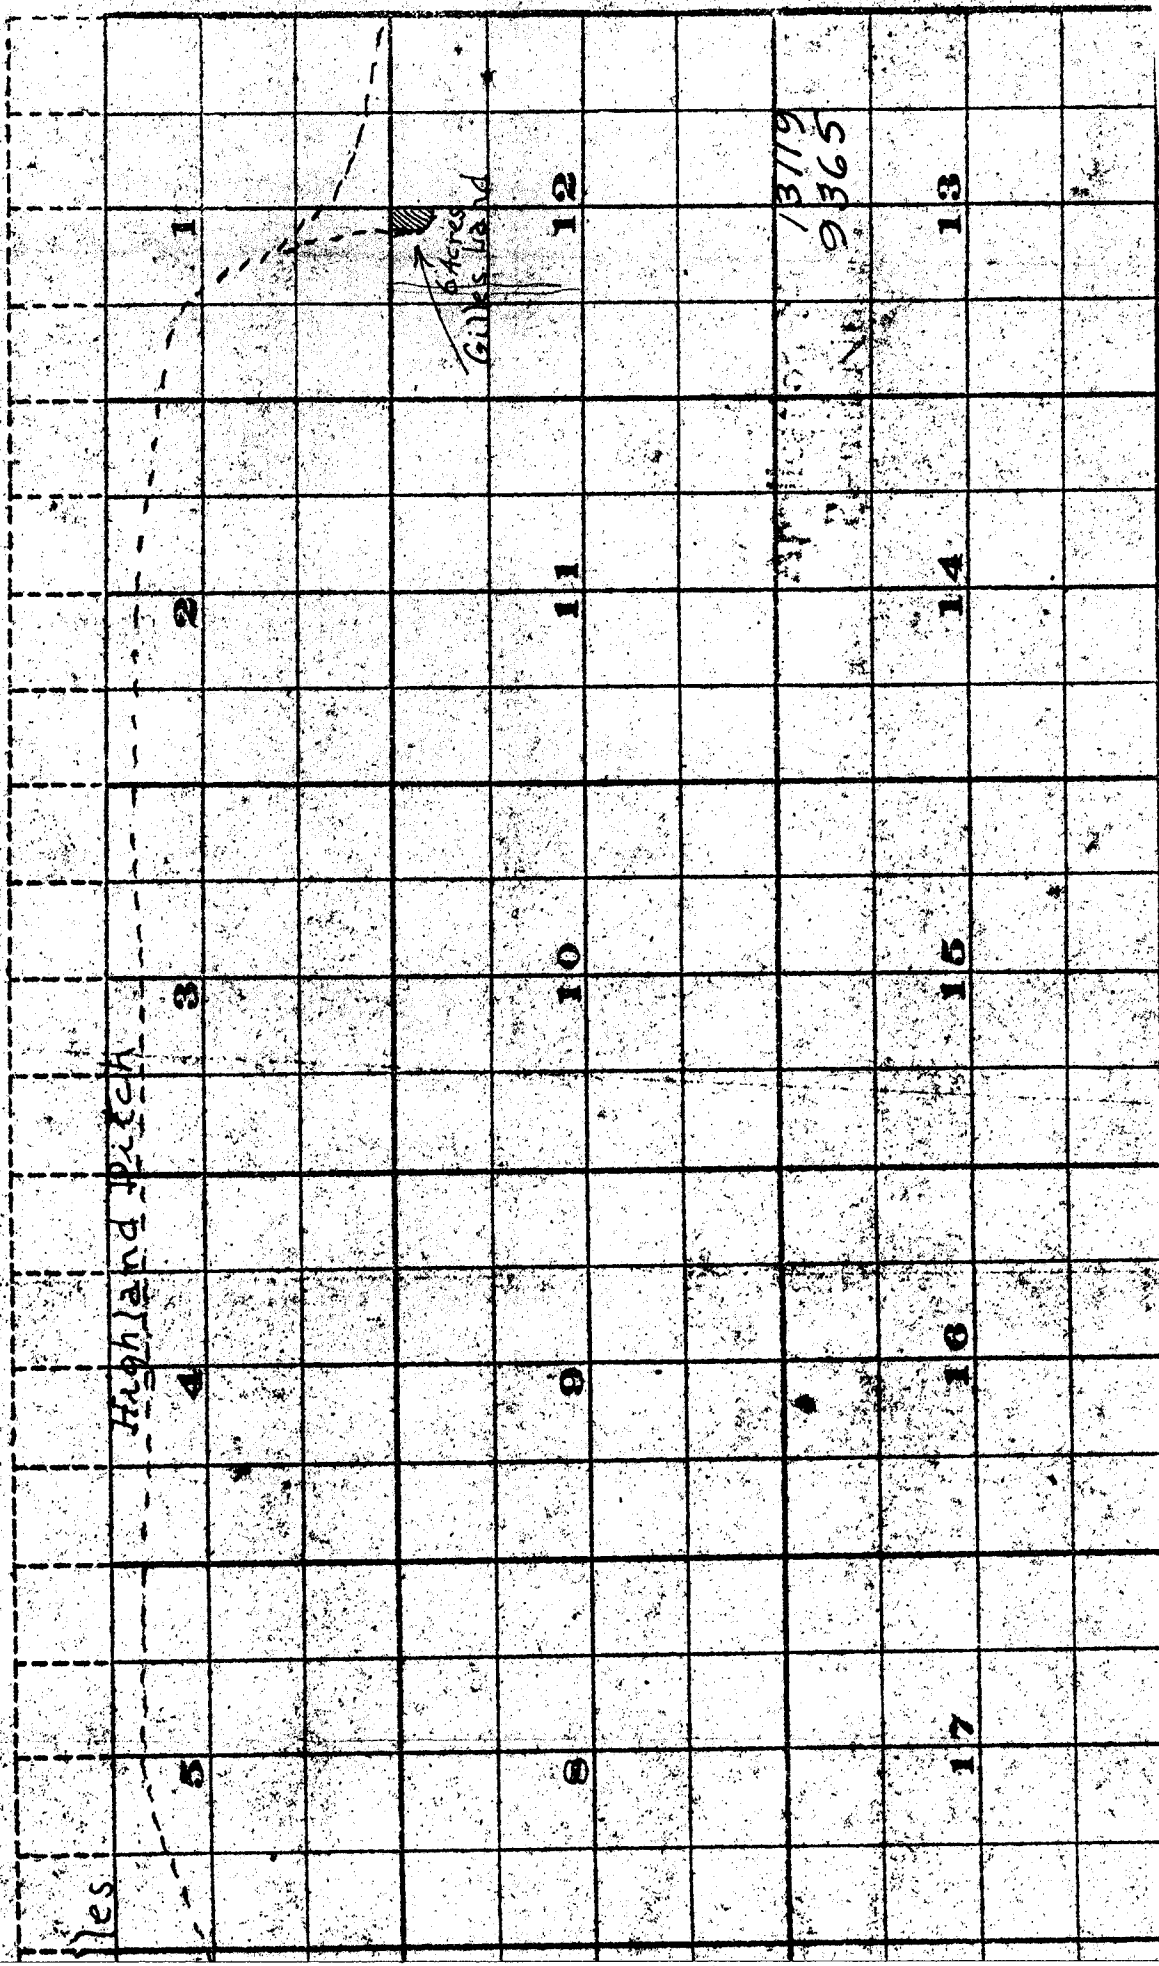

Highland Pitch

6 Acres
Gilles land

3119
9365