



**T25S, R33E,
SECTIONS 3 & 10, WM**
HARNEY COUNTY, OREGON

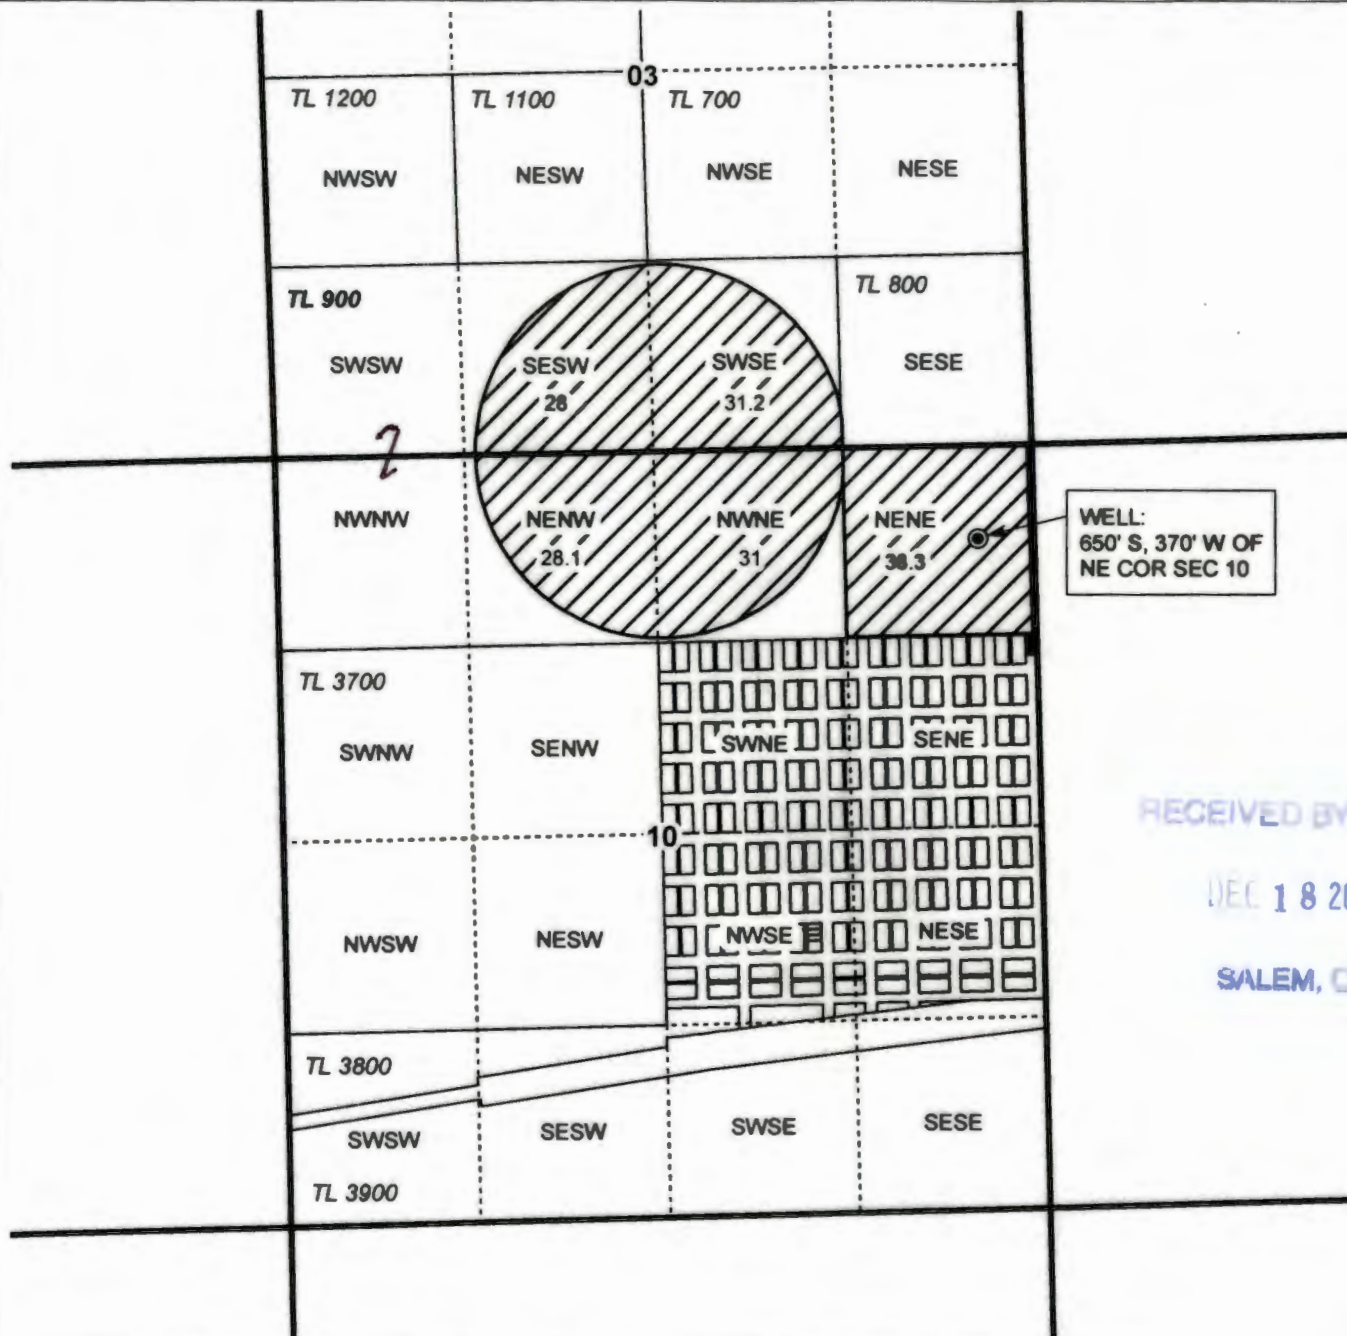

- Certificate 67661, Transfer ON
- Section
- Quarter Quarter
- Tax Lot
- Well

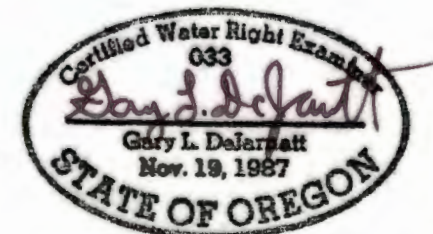

RENEWAL DATE 12/31/2017



CLAIM OF BENEFICIAL USE MAP
for Adams

TRANSFER T-12351

NOTE: THIS MAP IS NOT INTENDED TO
PROVIDE LEGAL DIMENSIONS OR LOCATIONS
OF PROPERTY OWNERSHIP LINES.

JOB # 17063

NOV 20, 2017

WATER RIGHT SERVICES, LLC
PO BOX 1830, BEND, OR 97709
CCB# 197121 www.oregonwater.us
541-389-2837 JOHNSHORT@USA.COM