


FINAL PROOF MAP FOR CHANGE IN POA AND
POU FOR LOT 7 REDTAIL MEADOWS
SUBDIVISION FOR C. 86742 LOCATED IN SE1/4
SW1/4 OF SECTION 12 AND IN NE1/4 NW1/4
OF SECTION 13, T.16S., R.16E., W.M., CROOK
COUNTY, OREGON W.O. 16-4759

T-12064


SCALE

1" = 200'

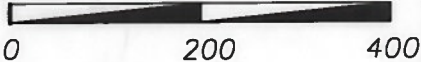

MAY 17, 2016

S.E. MEADOWLARK LANE

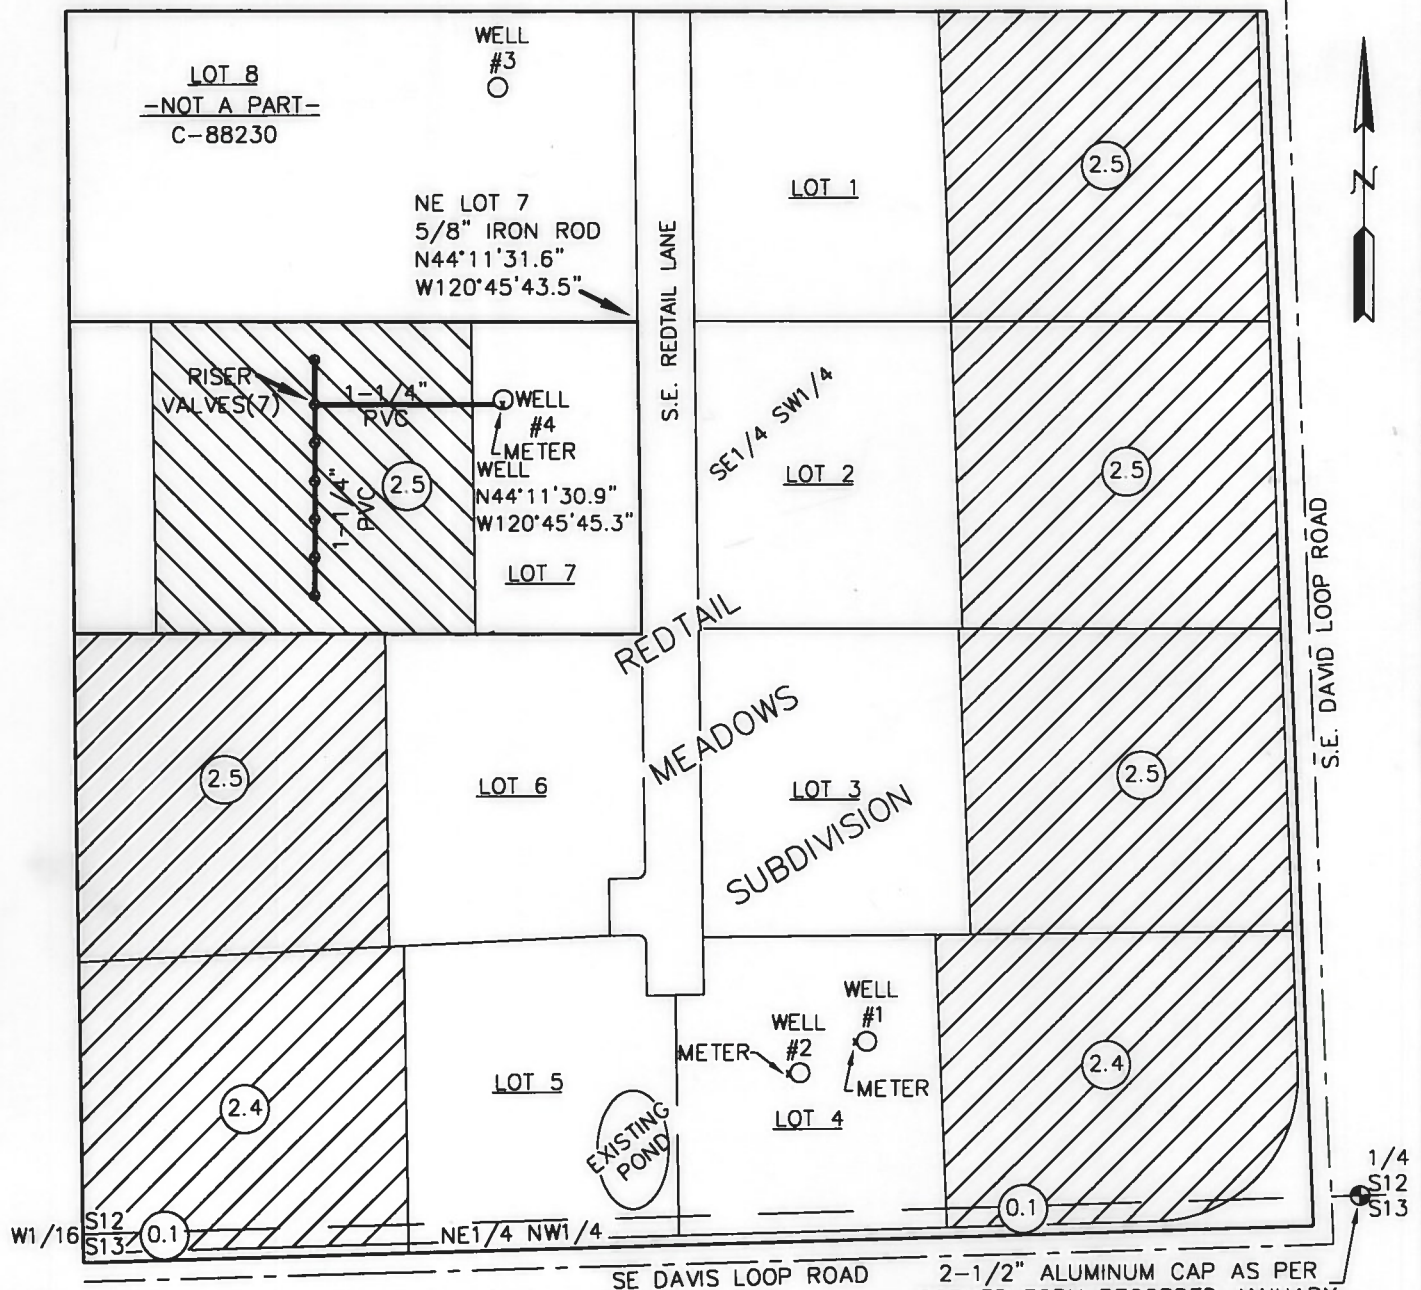

PREPARED FOR PREPARED BY

DAVID L. PETERSON
ROSEMARY PETERSON
P.O. BOX 1588
PRINEVILLE, OR 97754
(541)490-6524

ARMSTRONG SURVEYING
& ENGINEERING, INC
267 NE SECOND ST. STE 100
PRINEVILLE, OR 97754
(541) 447-7791

WATER RIGHTS

PRIMARY - C-86742 - NO CHANGE
T.16S., R.16E., W.M. TOTAL - 15.0 AC.

MAP 16-16-12C	PLAT	SECTION 12	SECTION 13
TAX LOT	LOT	SE1/4 SW1/4	NE1/4 NW1/4
700	1	2.5 AC.	-
701	2	2.5 AC.	-
702	3	2.5 AC.	-
703	4	2.4 AC.	0.1 AC.
704	5	2.4 AC.	0.1 AC.
705	6	2.5 AC.	-
	TOTAL	14.8 AC.	0.2 AC.

EXISTING WELL LOCATIONS - CERTIFICATE 86742
WELL #1 - LOCATED IN SE1/4 SW1/4 SECTION 12, T.16S.,
R.16E., W.M., 178 FT. NORTH AND 510 FT.
WEST OF THE S1/4 CORNER SECTION 12.

WELL #2 - LOCATED IN SE1/4 SW1/4 SECTION 12, T.16S.,
R.16E., W.M., 147 FT. NORTH AND 581 FT.
WEST OF THE S1/4 CORNER SECTION 12.

CHANGE IN POINT OF APPROPRIATION - LOCATION
WELL #4 - LOCATED IN SE1/4 SW1/4 SECTION 12, T.16S.,
R.16E., W.M., 840 FT. NORTH AND 900 FT.
WEST OF THE S1/4 CORNER SECTION 12.


RECEIVED BY OWRD

JUN 01 2016

SALEM, OR

MAP NOTE

THE PREPARATION OF THIS MAP IS FOR THE PURPOSE OF IDENTIFYING
THE LOCATION OF THE WATER RIGHT ONLY AND HAS NO INTENT TO
PROVIDE DIMENSIONS OR LOCATIONS OF PROPERTY OWNERSHIP LINES.

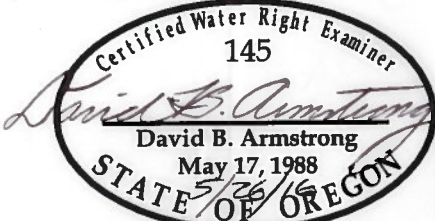

Renews December 31, 2017

PRIMARY - C-86742 - CHANGE POA & POU
T.16S., R.16E., W.M. TOTAL - 2.5 AC.

MAP 16-16-12C	PLAT	SECTION 12	SECTION 13
TAX LOT	LOT	SE1/4 SW1/4	NE1/4 NW1/4
706	7	2.5 AC.	-

DRG. NO. 10-3985.DWG
W.O. 16-4759