

T.6S. R.2W. Section 28, W.M.

RECEIVED


DEC 08 2017

OWRD



RENEWED June 30, 2019

62nd Avenue NE

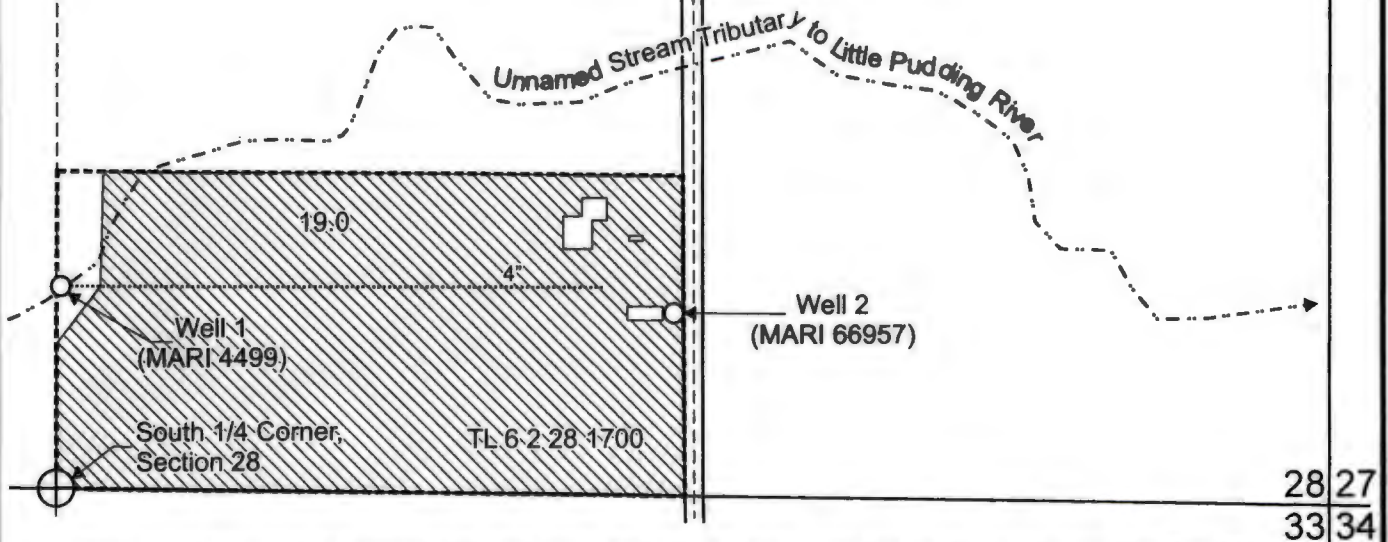

Well 1 (MARI 4499) is located 420 feet north and 10 feet east from the south 1/4 Corner, Section 28.


Well 2 (MARI 66957) is located 360 feet north and 1,295 feet east from the south 1/4 Corner, Section 28.

Area (19.0 Acres) affected by T-11946.

Tax lot boundary

Mainline connecting Well 1
Well 2 uses potable pipe

Scale: 1" = 400'

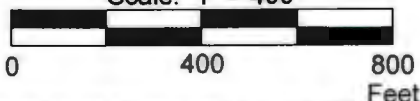

This map was prepared for the purpose of identifying the location of a water right only and is not intended to provide legal dimensions or location of property ownership lines.

Claim of Beneficial Use Map
T-11946

Zielinski Children Irrevocable Trust c/o Dolores Wells, Trustee
T.6S. R.2W. Section 28, W.M.