


T. 16 S. R. 6 W. W. M.

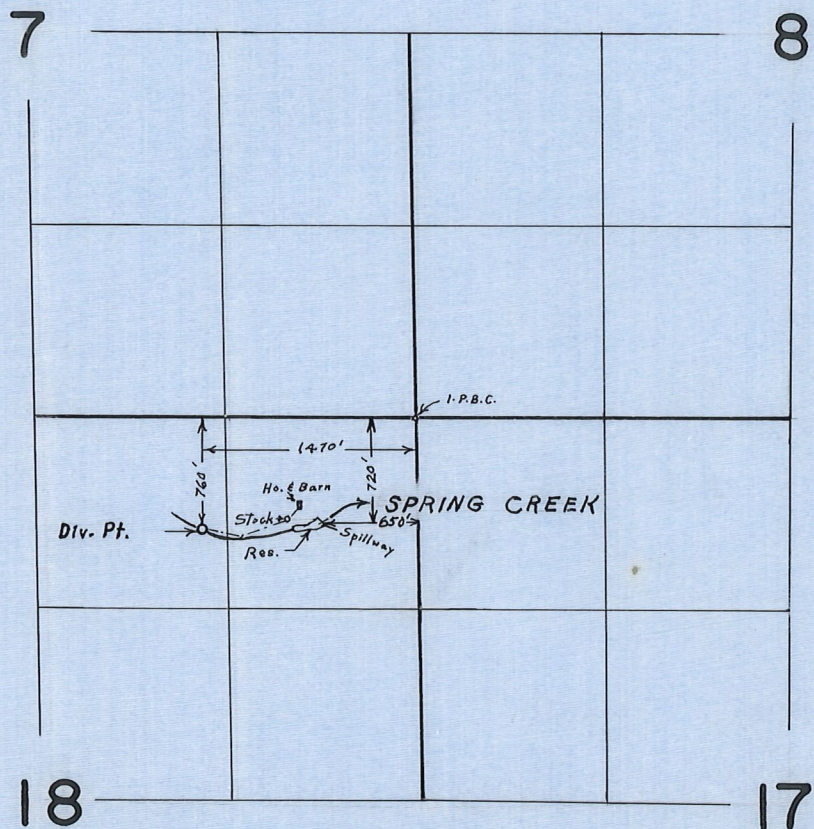

FINAL PROOF SURVEY
UNDER

R-41073 R-4615
Application No. 41074 Permit No. 30643
IN NAME OF
A. C. HUBBARD

Surveyed April 16, 1969, by L. E. Gould