


# T. 28 S.R. 7 W.W.M.

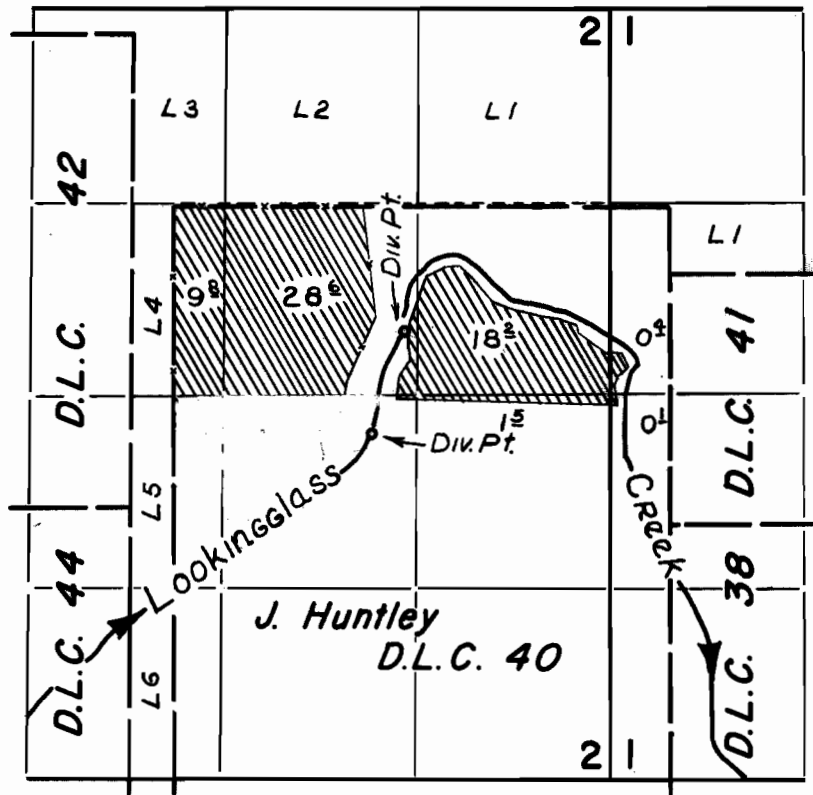


## FINAL PROOF SURVEY UNDER

Application No. 32811.. Permit No. 25902..  
IN NAME OF

**FRED SCHULZE**

Surveyed July 31 1962., by C.R. Baker.....

# Looking Glass Organic Farms, LLC Certificate 57718 Transfer APOD Township 28S, Range 7W

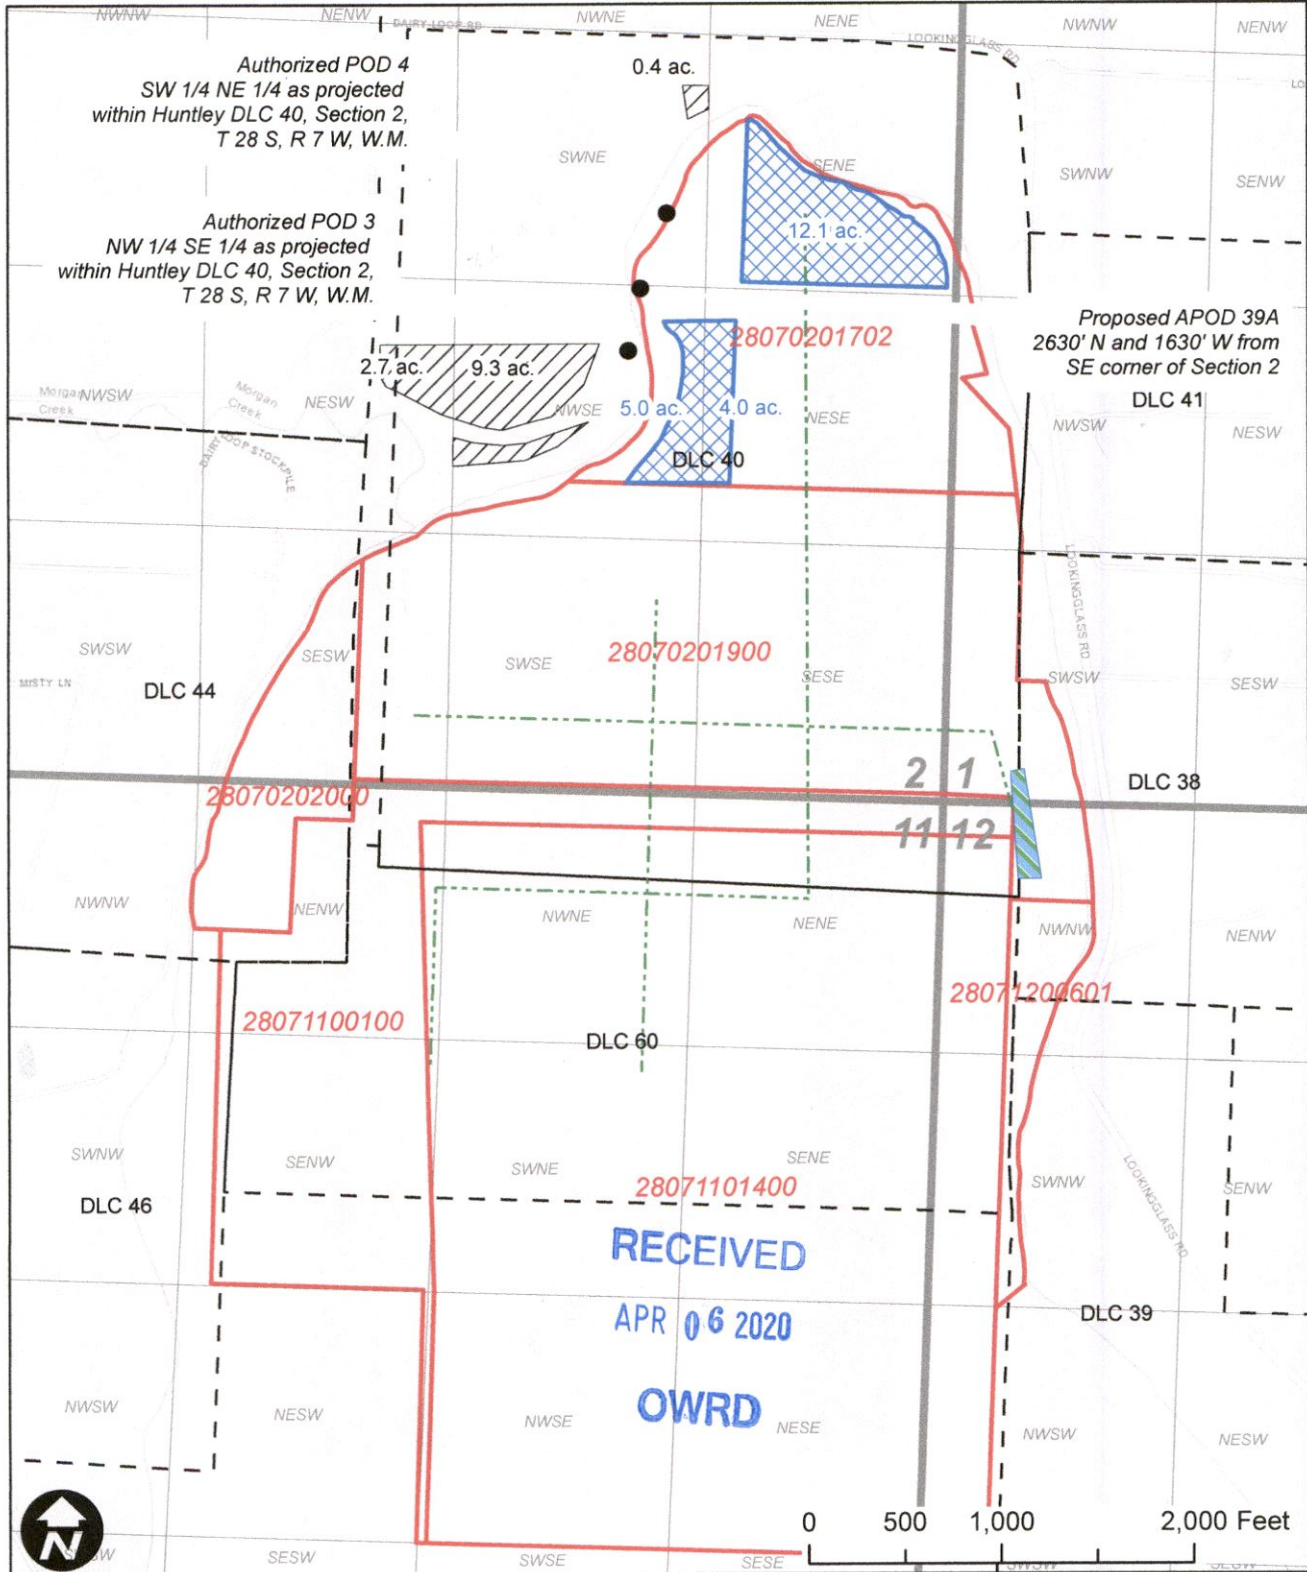

- Cert. 57718 APOA
- Mainline
- DLC
- Cert. 57718 No Change
- Bulge
- Tax Lot

**WILL MCGILL SURVEYING LLC**  
 15333 Pletzer Rd. SE 503-510-3026  
 Turner, OR 97392 willmcgill.surveying@gmail.com

**CERTIFIED WATER RIGHT EXAMINER**  
**30680**  
*William E. McGill*  
**WILLIAM E. MCGILL**  
**MAY 3, 2011**  
**STATE OF OREGON**  
**EXPIRES: 12/31/2020**