


Claim of Beneficial Use Map

Bobby R. and Billie L. Evans

T-8314

T 40 S, R 18 E, WM
Section 24 & 25

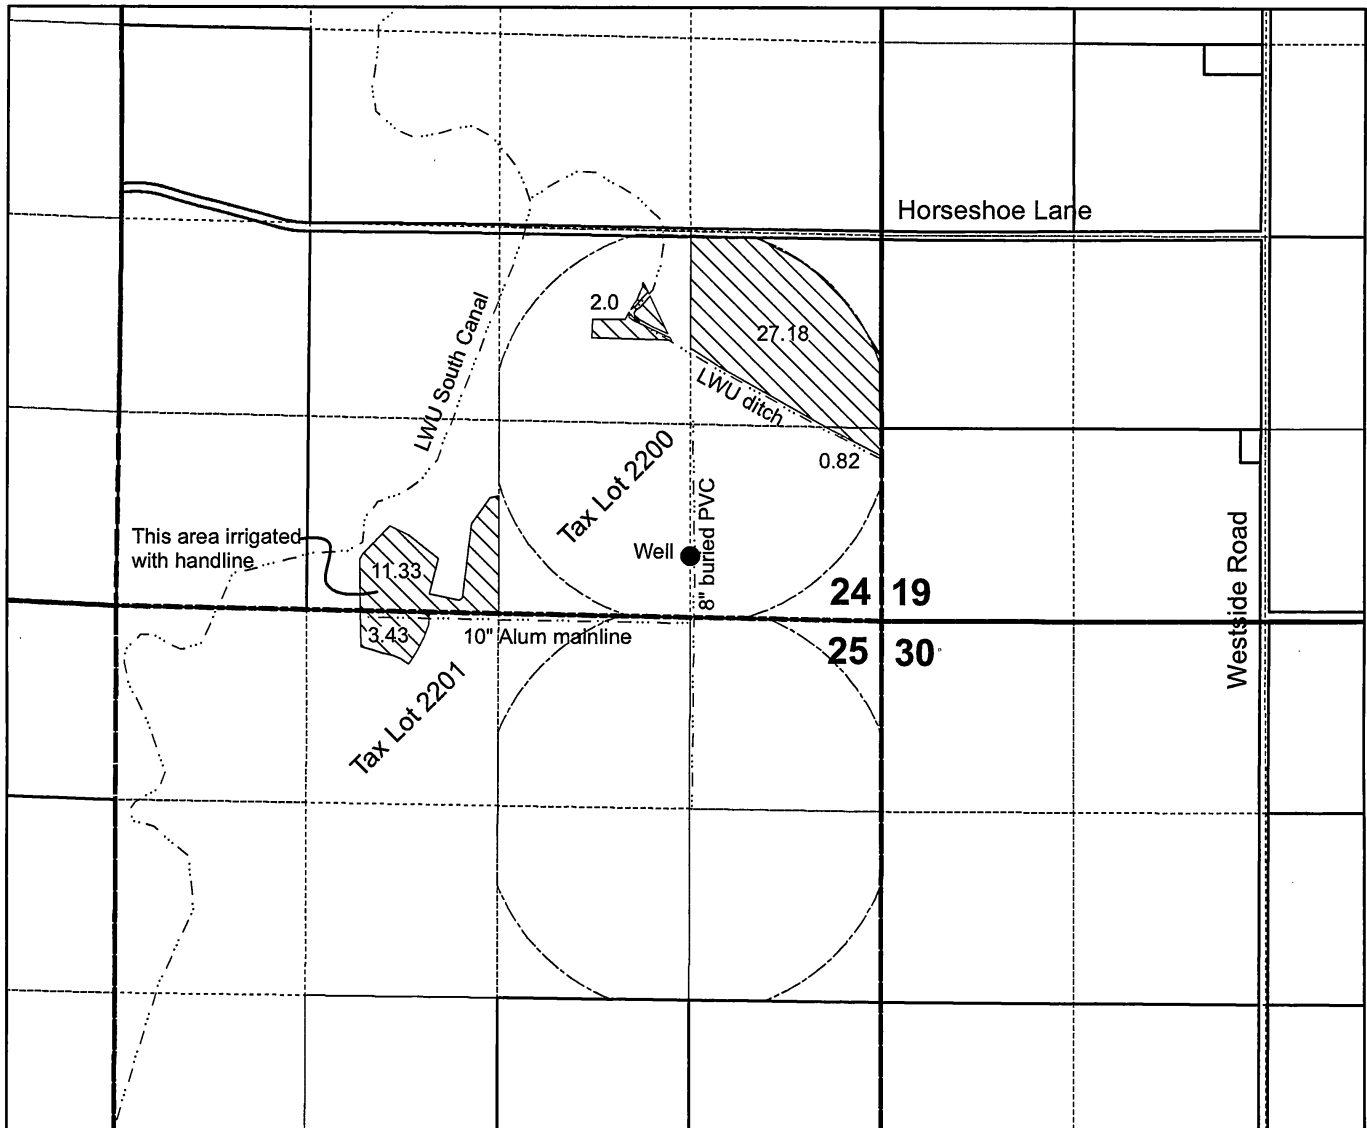

Legend


- Well
- - - - LWU ditch
- Pivots
- ▨ T-8314 used

RECEIVED

DEC 09 2019

OWRD

Well is located
400 ft North & 1300 ft West
From SE Cor. Sec 24, T40S, R18E

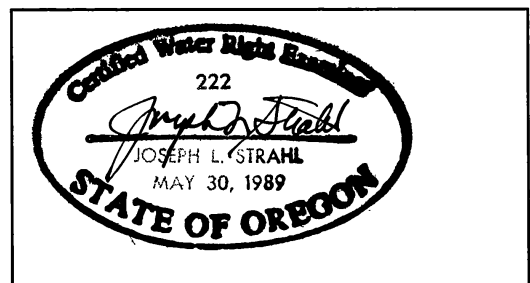

N



1 inch = 1,320 feet

Note: This map is not intended to provide legal dimensions or locations of property ownership lines.

Bobby R. & Billie L. Evans Water Right Transfer Map Certificate 87093 & 95027


T 40 S, R 18 E, WM
Section 24 & 25

Map 2 of 3

RECEIVED

JUL 27 2020

OWRD

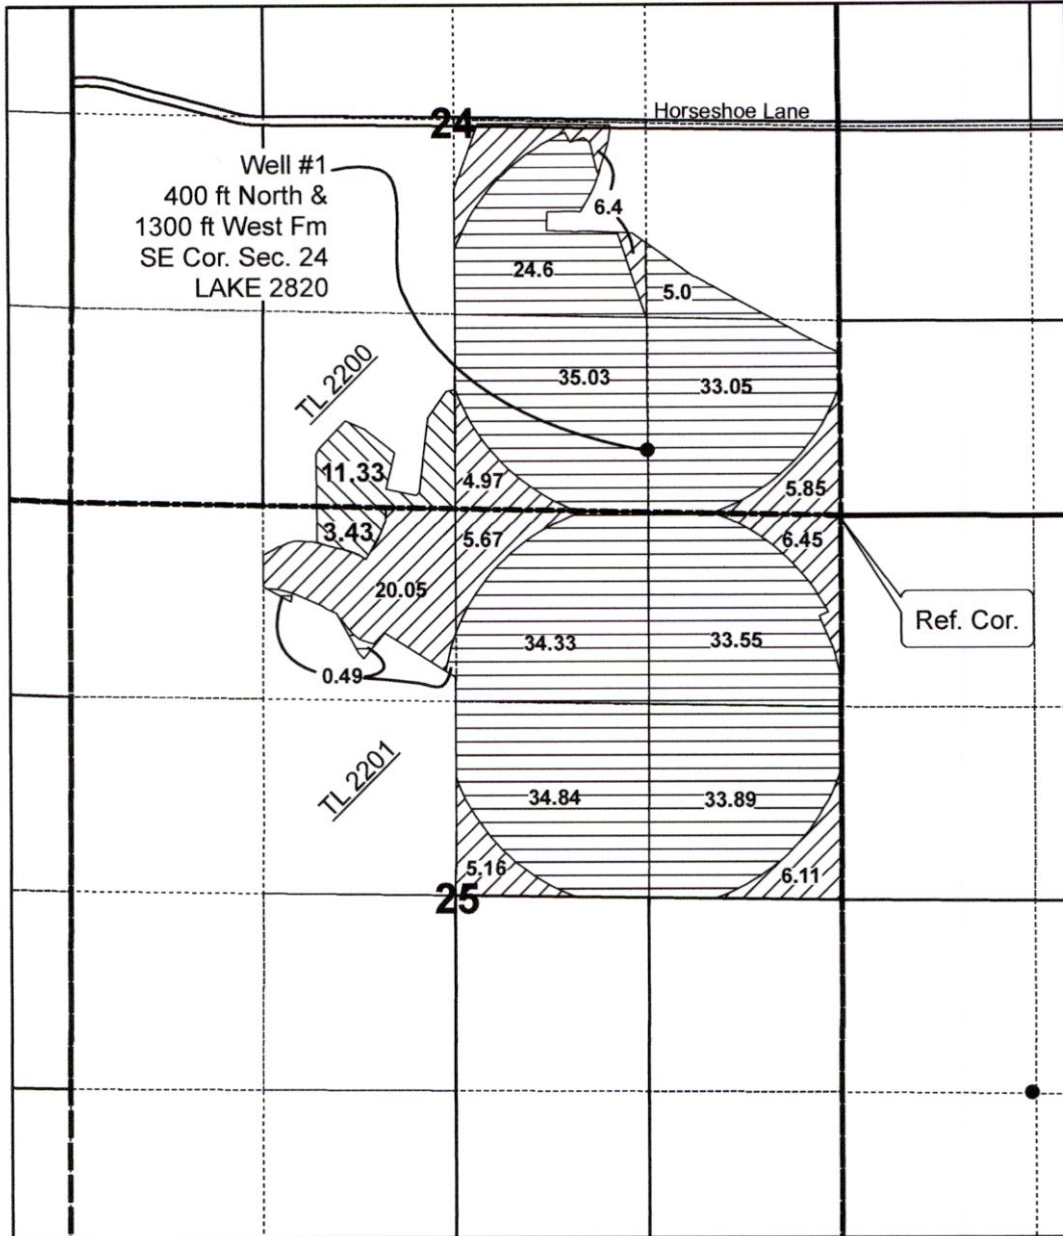


Legend

-  Cert 87093 No Change
-  Cert 87093 From 60.66 ac
-  C 95027 From 14.76 ac
- Wells

N



1 inch = 1,320 feet

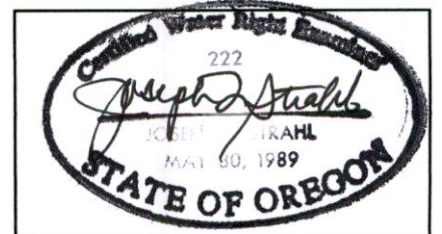

Note: This map is not intended to provide legal dimensions or locations of property ownership lines.

13502

Bobby R. & Billie L. Evans Water Right Transfer Map Certificate 53146, 87093 & 95027


T 40 S, R 18 E, WM
Section 36

Map 3 of 3

RECEIVED

JUL 27 2020

OWRD

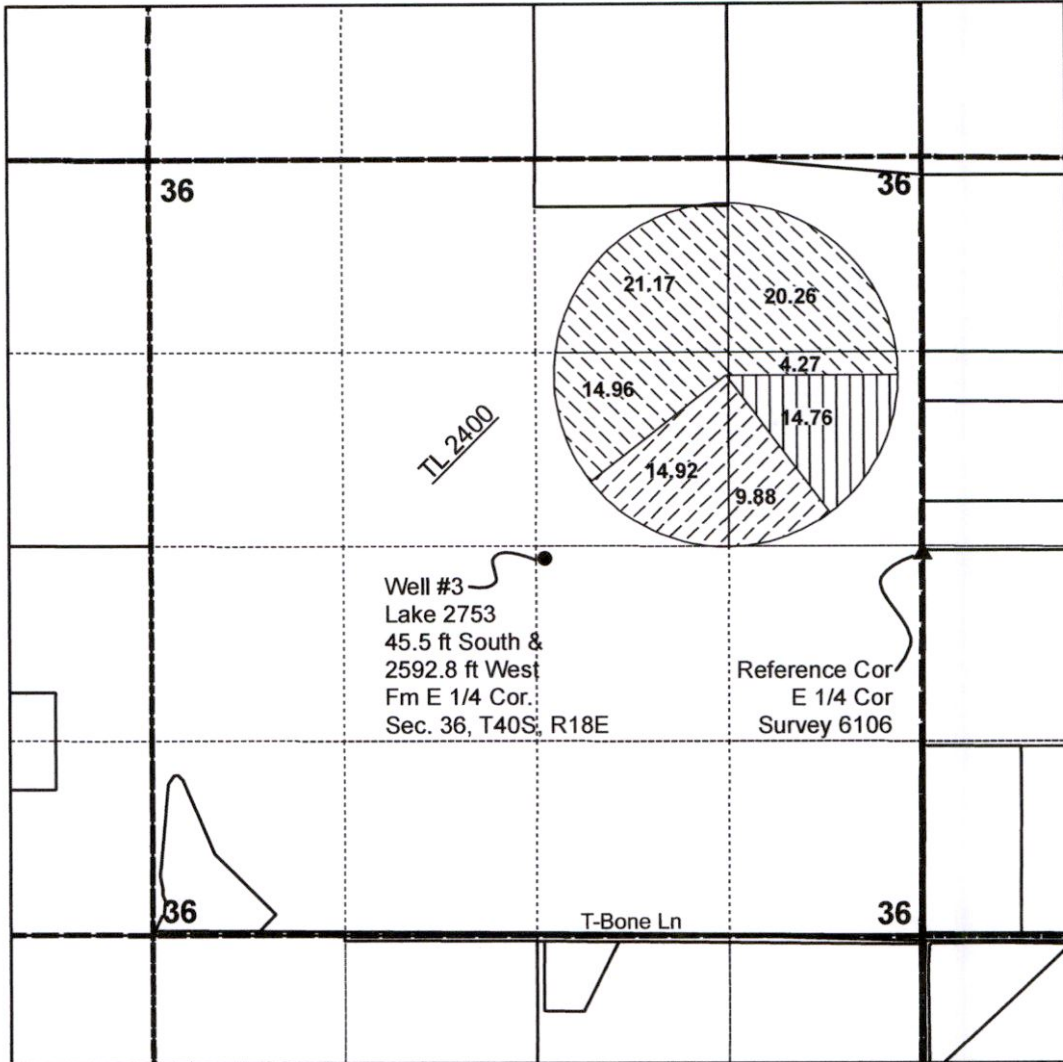


Legend

- C53146 TO 24.8 ac
- C87093 TO 60.66 ac
- C95027 TO 14.76 ac
- Wells
- ▲ Ref Cor LCS 6106



1 inch = 1,320 feet

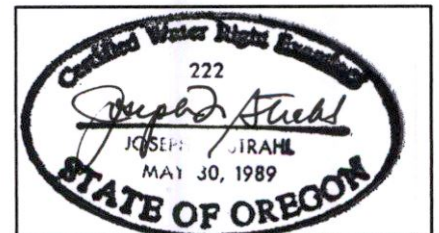

Note: This map is not intended to provide legal dimensions or locations of property ownership lines.

13502

Bobby R. & Billie L. Evans
Proof of Use index map
Certificate 53146, 87093 & 95027

RECEIVED

JUL 27 2020

OWRD

