



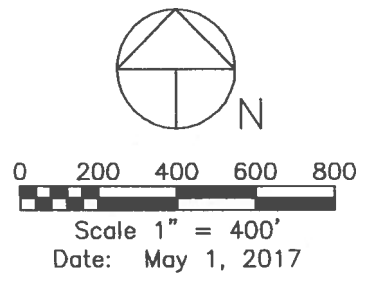

1084



CLAIM OF BENEFICIAL USE MAP  
 APPLICATION R-87671 PERMIT R-14936  
 APPLICATION S-87771 PERMIT S-54746  
 FOR  
 MARK THORKELSON  
 1080 CANTRALL ROAD  
 JACKSONVILLE, OR 97530  
 LOCATED IN  
 TAX LOT 103, SECTION 32, T.38S., R.3W., W.M.  
 JACKSON COUNTY, OREGON

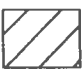

LEGEND

- Survey Monument
-  Denotes Place of Use Agriculture Use, Irrigation, Livestock
-  Denotes Staff Gage Location
-  Denotes Flow Meter Location
- Denotes Maximum Pool Level
- Denotes Unnamed Creek
- △ Denotes Point of Diversion No. 1 Fish Screen at P.O.D.

This map was prepared for the purpose of identifying the location of a water right only and is not intended to provide legal dimensions or location of property ownership.

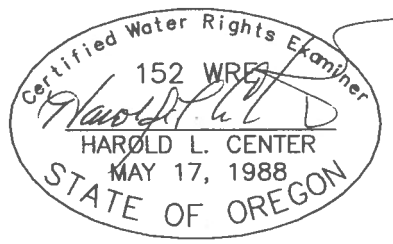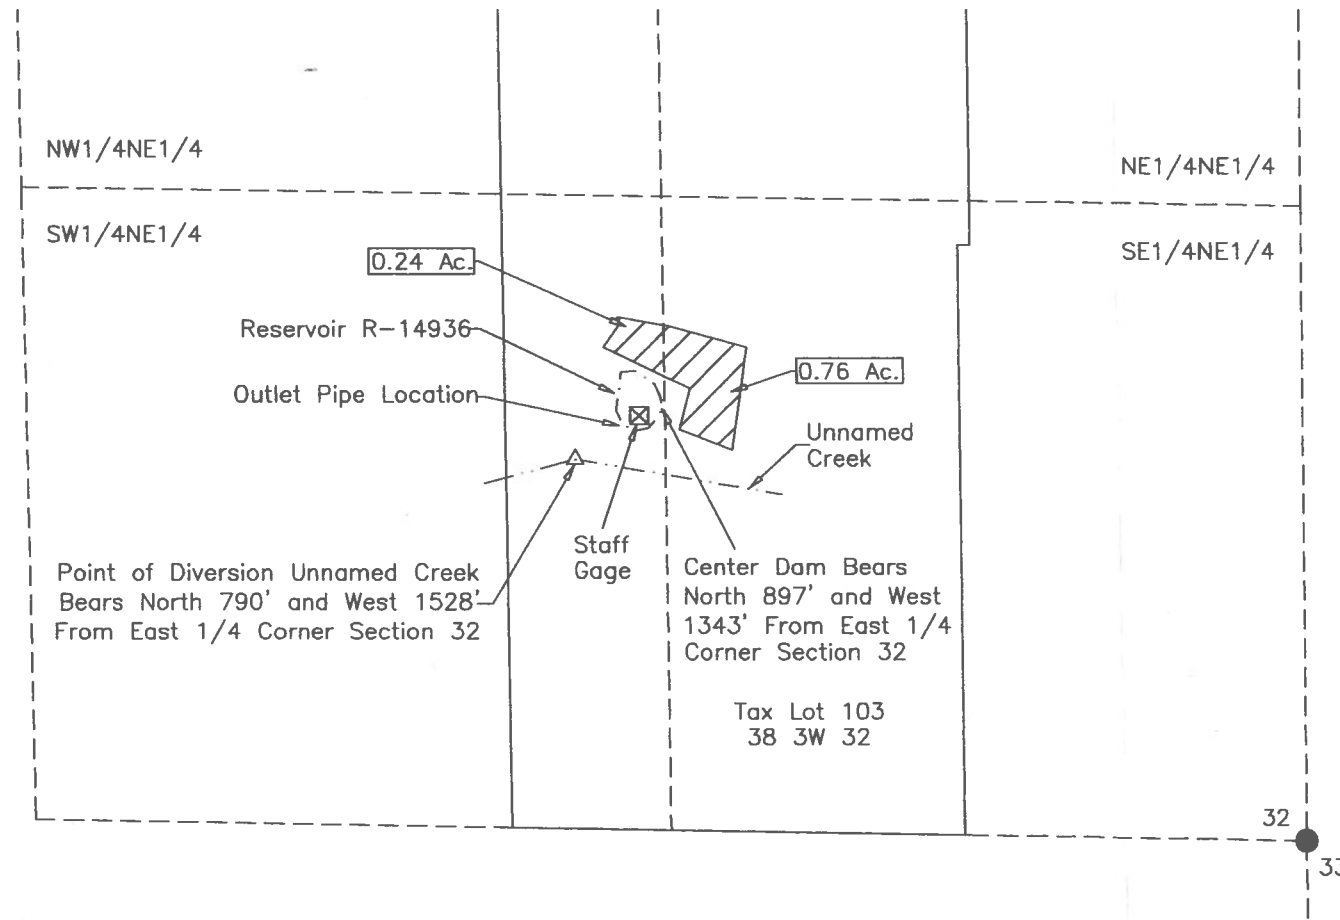

HAROLD L. CENTER  
 2604 David Lane  
 Medford, OR. 97504  
 Phone 541-535-6108  
 Oregon Certificate No. 152

Renews: 12/31/17

Project: 16-40 THORK.DWG

COBU MAP # 1084

RECEIVED BY OWRL

JUN 12 2017

SALEM, OR