


CLAIM OF BIOLOGICAL USE MAP

APPLICATION R-87454 PERMIT R-14791
S17 & 20, T3S, R3W, WM
TAX LOT 101
YAMHILL COUNTY, OR
WILLAMETTE RIVER BASIN

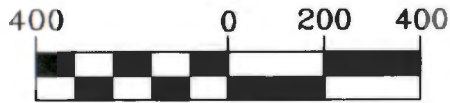

1 inch = 400 ft.

LEGEND

DLC/GOVT LOT LINE
1/16TH SECTION LINE
TAX LOT LINE




Stuntzner

Engineering
& Forestry, LLC



Project: 316-019
Drawing: COBU R-14791.dwg
By: JAK
Date: OCT 17, 2016

THIS MAP WAS PREPARED FOR THE PURPOSE OF IDENTIFYING THE LOCATION OF A WATER RIGHT ONLY AND IS NOT INTENDED TO PROVIDE LEGAL DIMENSIONS OR LOCATION OF PROPERTY OWNERSHIP LINES.

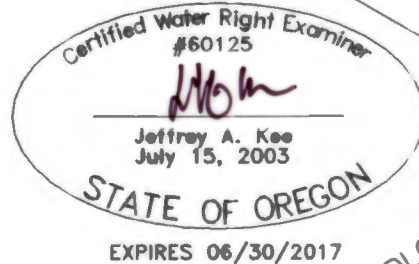

DLC #49

PREPARED FOR:
REVANA VINEYARDS
12001 NE WORDEN HILL ROAD
NEWBERG, OREGON

GOVT
LOT 2

SE QTR
OF SE

SW QTR
OF SW

17 16

TAX
LOT
101

20

21

SECTION
CORNER

8 INCH STAND PIPE

500'

740'

POD
#1

REVANA #1
RESERVOIR

NW QTR
OF NW

NE QTR
OF NE

GOVT
LOT 1

GOVT
LOT 2

RECEIVED BY OWRD

NOV 07 2016

SALEM, OR