


**EXHIBIT A: CLAIM OF BENEFICIAL USE MAP**  
**TELLY AND AMORITA WIRTH**  
**TAX LOT 100 MAP 13S-3W-6**  
**LOCATED IN THE VINEYARD C. BROCK DLC 49**  
**LINN COUNTY, OREGON**  
**JUNE 1, 2017**

RECEIVED BY OWRD


JUL 20 2017

SALEM, OR

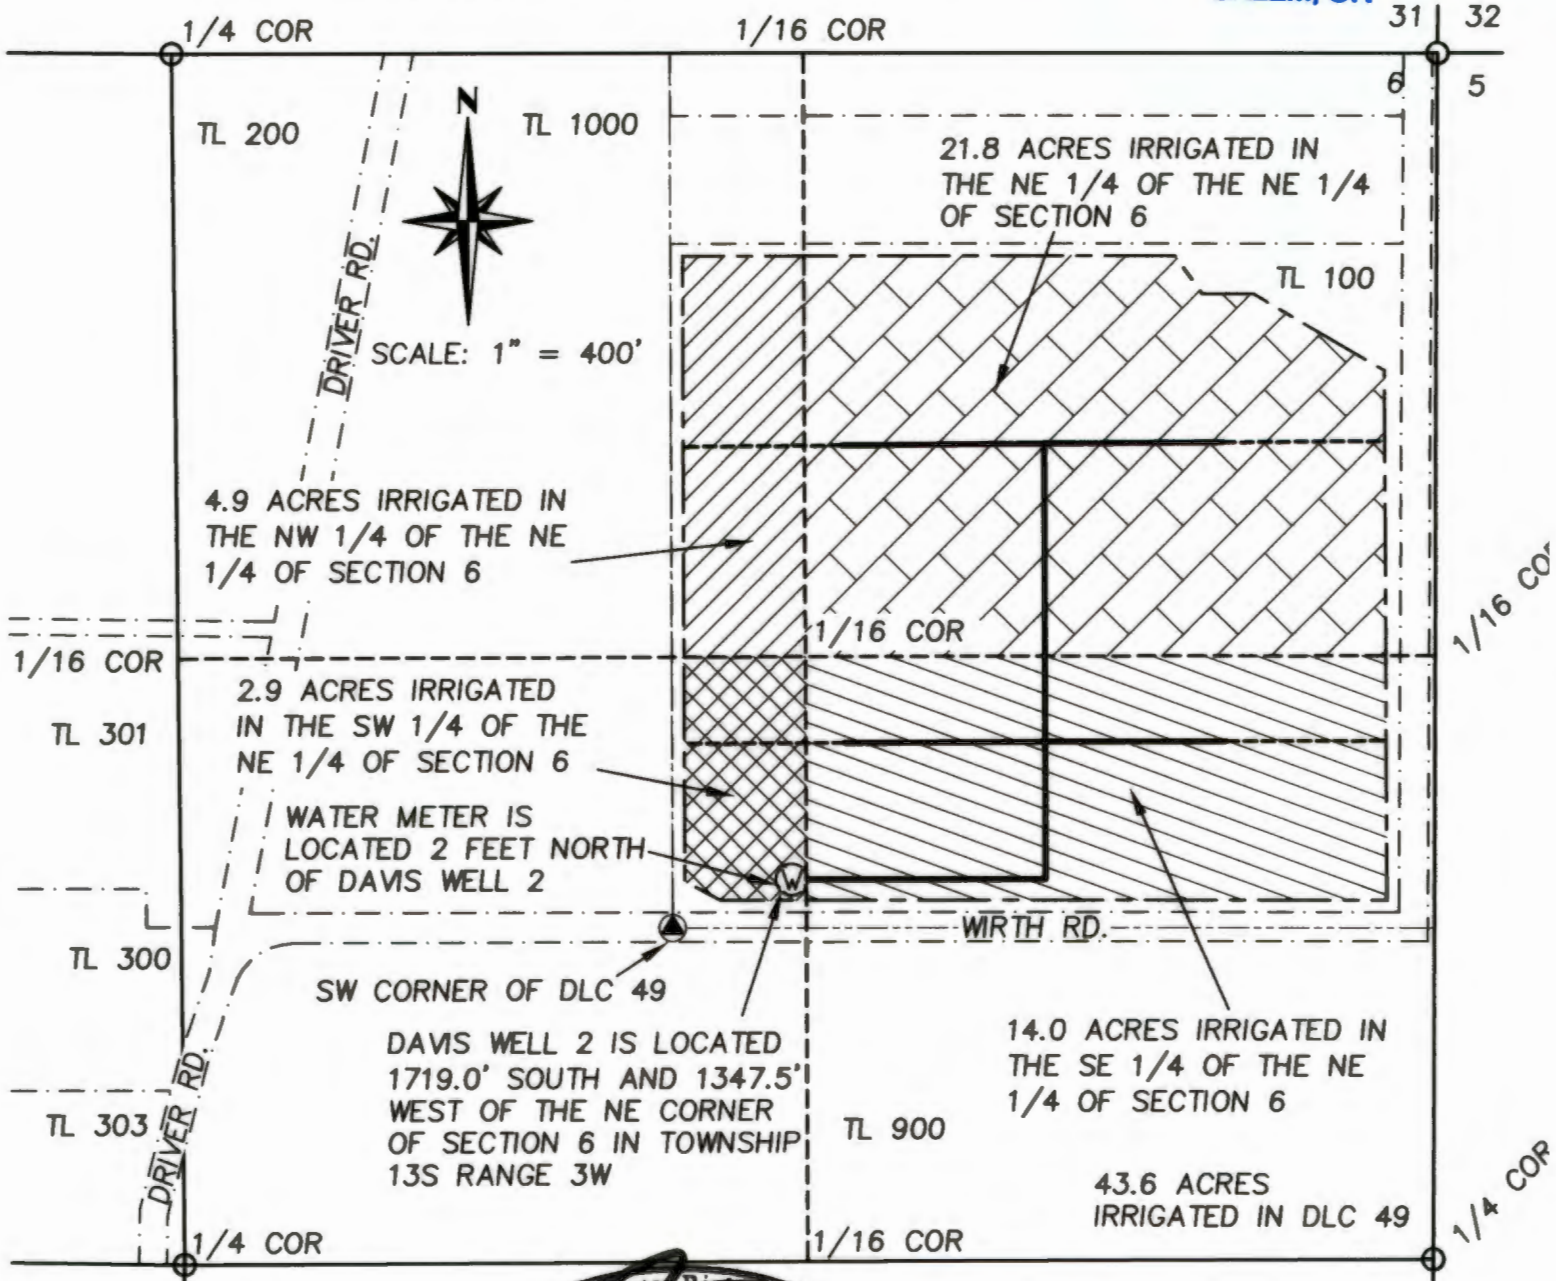

**LEGEND**

- SECTION LINE
- - - QUARTER SECTION LINE
- - - TAXLOT BOUNDARY
- - - DLC BOUNDARY
- - - IRRIGATION BOUNDARY
- - - 2" PVC PIPE
- - - 3" PVC PIPE
- ⊙ WELL
- ▨ IRRIGATED AREA IN NE1/4 OF NE1/4 OF SECTION 6
- ▩ IRRIGATED AREA IN SE1/4 OF NE1/4 OF SECTION 6
- ▧ IRRIGATED AREA IN SW1/4 OF NE1/4 OF SECTION 6
- ▦ IRRIGATED AREA IN NW1/4 OF NE1/4 OF SECTION 6

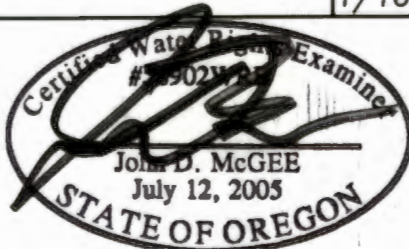

RENEWAL DATE: 12/31/2018

POSITIONS OF STRUCTURES RELATIVE TO THE NE CORNER OF SECTION 6 ARE BASED ON A GPS SURVEY

THIS MAP IS NOT INTENDED TO PROVIDE LEGAL DIMENSIONS OR LOCATIONS OF PROPERTY OWNERSHIP LINES.

JDMcGee, Inc.  
 Engineering & Surveying 1215 Main Street  
 Land Use Planning PO Box 1472  
 Wastewater Design Phnomath, OR 973  
 "Solving Problems for You" (541) 928-4226  
 (541) 928-4227 A  
 DRAWN BY: RJM  
 JDM PROJECT #: 07-34A  
 CHECKED BY: JDM