


# T4S, R1E, WM

CLACKAMAS COUNTY

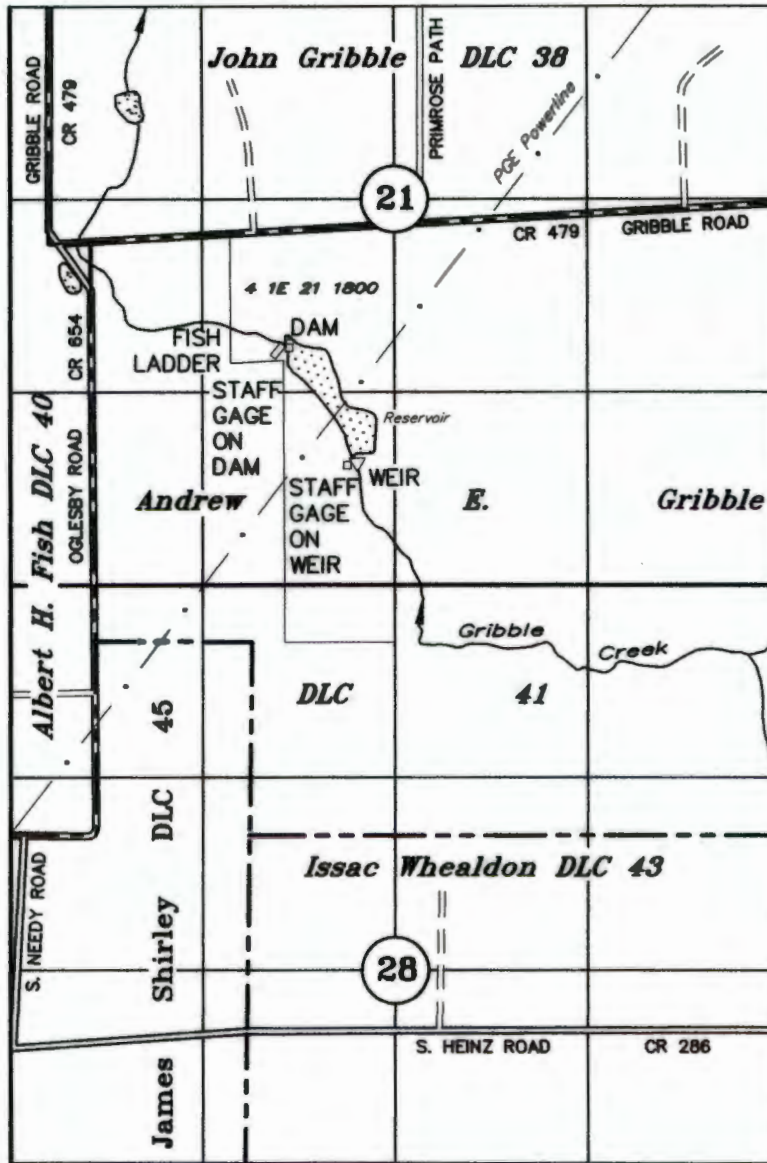

RECEIVED  
DEC 17 2017  
OWRD

### LEGEND

- DAM (POD)
- FISH LADDER
- STAFF GAGE
- ▽ WEIR

DAM: 704' SOUTH AND 1298' EAST OF THE NW COR ANDREW E. GRIBBLE DLC No 41  
 DAM STAFF GAGE: 730' SOUTH AND 1306' EAST OF THE NW COR ANDREW E. GRIBBLE DLC No 41  
 WEIR: 1533' SOUTH AND 1780' EAST OF THE NW COR ANDREW E. GRIBBLE DLC No 41  
 WEIR STAFF GAGE: 1535' SOUTH AND 1778' EAST OF THE NW COR ANDREW E. GRIBBLE DLC No 41

## CLAIM OF BENEFICIAL USE

UNDER


Application R-86639 Permit R-14542

IN THE NAME OF

**ARTHUR SPADA**

NOVEMBER 29, 2017

SCALE: 1" = 1320'

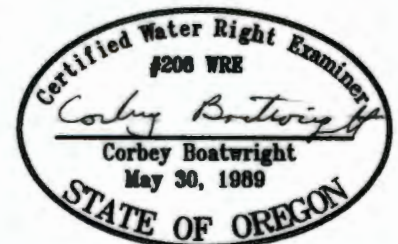

RENEWAL DATE: 12-31-17

NOTE: This map is not intended to provide legal dimensions or locations of property ownership lines.