

T.3S. R.1W. Section 36, W.M.

Anderson DLC 55

36


Point of Diversion is located 220 feet north and 1,450 feet west from the S 1/4 corner of Section 36.

 Area (22.3 acres) irrigated under T-11812


 Tax lot boundary

 Donation Land Claim boundary

 Irrigation main line

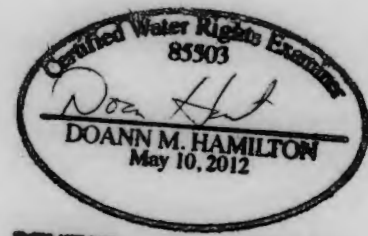

RECEIVED JUN 30 2019

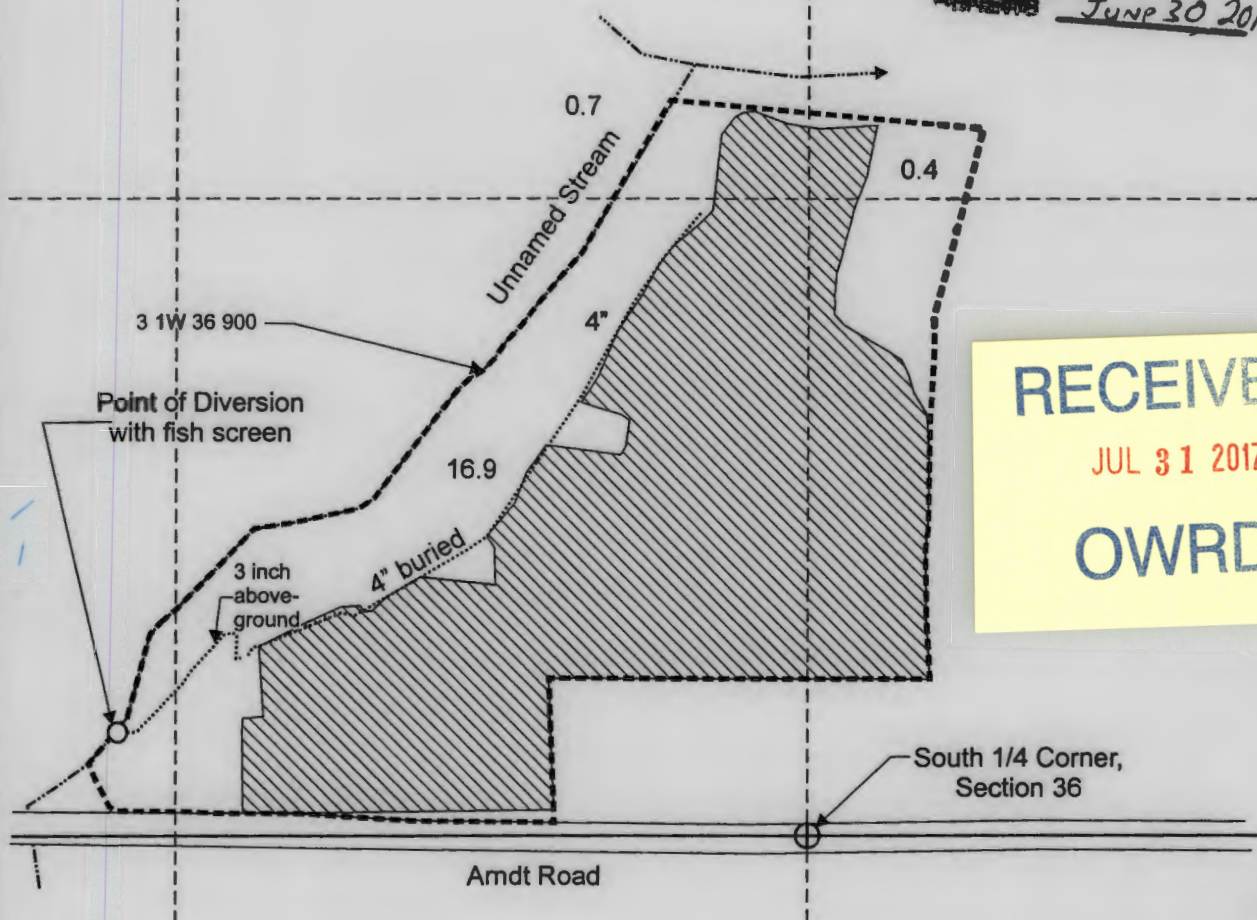


RECEIVED

JUL 31 2017

OWRD

Scale: 1" = 400'

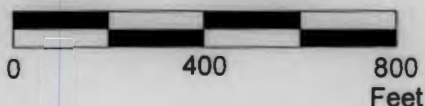

This map was prepared for the purpose of identifying the location of a water right only and is not intended to provide legal dimensions or location of property ownership lines.

Claim of Beneficial Use Map
T-11812

Romaine's Produce and Bakery LLC
T.3S. R.1W. Section 36. W.M.

Pacific Hydro-Geology Inc.

07/2017