



# T.4S. R.1E. Section 32, W.M.

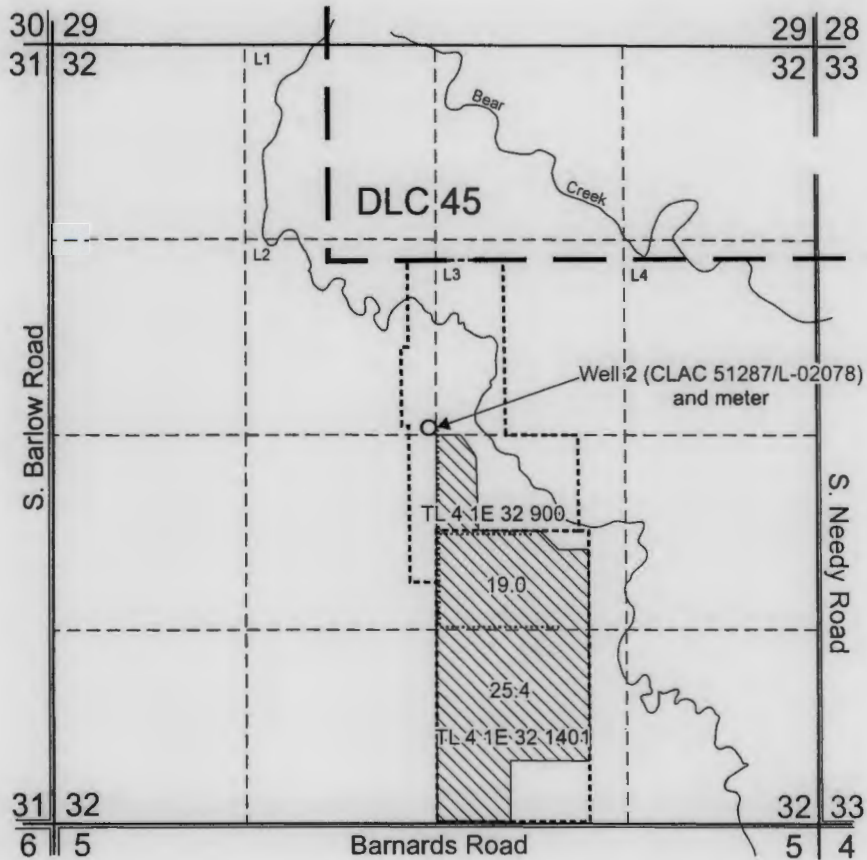

Well 2 (CLAC 51287/L-02078) and meter are located 50 feet north and 50 feet west from the C 1/4 corner of Section 32.

 Area irrigated (44.4 Acres) under Transfer 8333


----- Tax lot boundary

..... 6 inch Mainline



EXPIRATION DATE: 6/30/2017

Scale: 1" = 1,320'

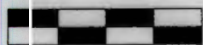

0 1,320 Feet

This map was prepared for the purpose of identifying the location of a water right only and is not intended to provide legal dimensions or location of property ownership lines.

Claim of Beneficial Use Map  
Transfer 8333

Raymon J. Neuschwander  
T.4S. R.1E. Section 32, W.M.

Pacific Hydro-Geology Inc.

10/2012 - bgp