


Jan 20/50  
22203

T. 1 S. R. 21 E. W. 11

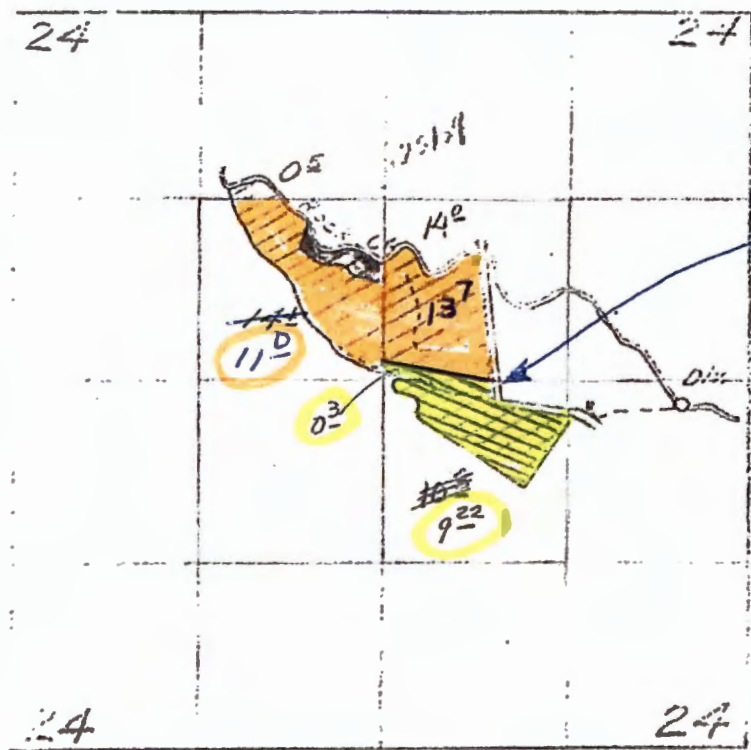

PROPERTY LINE  
BETWEEN  
ROCK CR. CROSSING LLC  
AND HIATT

- ROCK CREEK CROSSING LLC DIM TO SUPPLEMENTAL
- GARY HIATT ETAL RR Primary

Final Proof Survey  
Under

Application No. 25436 Permit No. 20730  
In Name Of

Orie L. Conway

Surveyed July 16, 1955 by T. Jones