




T.3S. R.2W. Sec. 29 & 30, W.M.

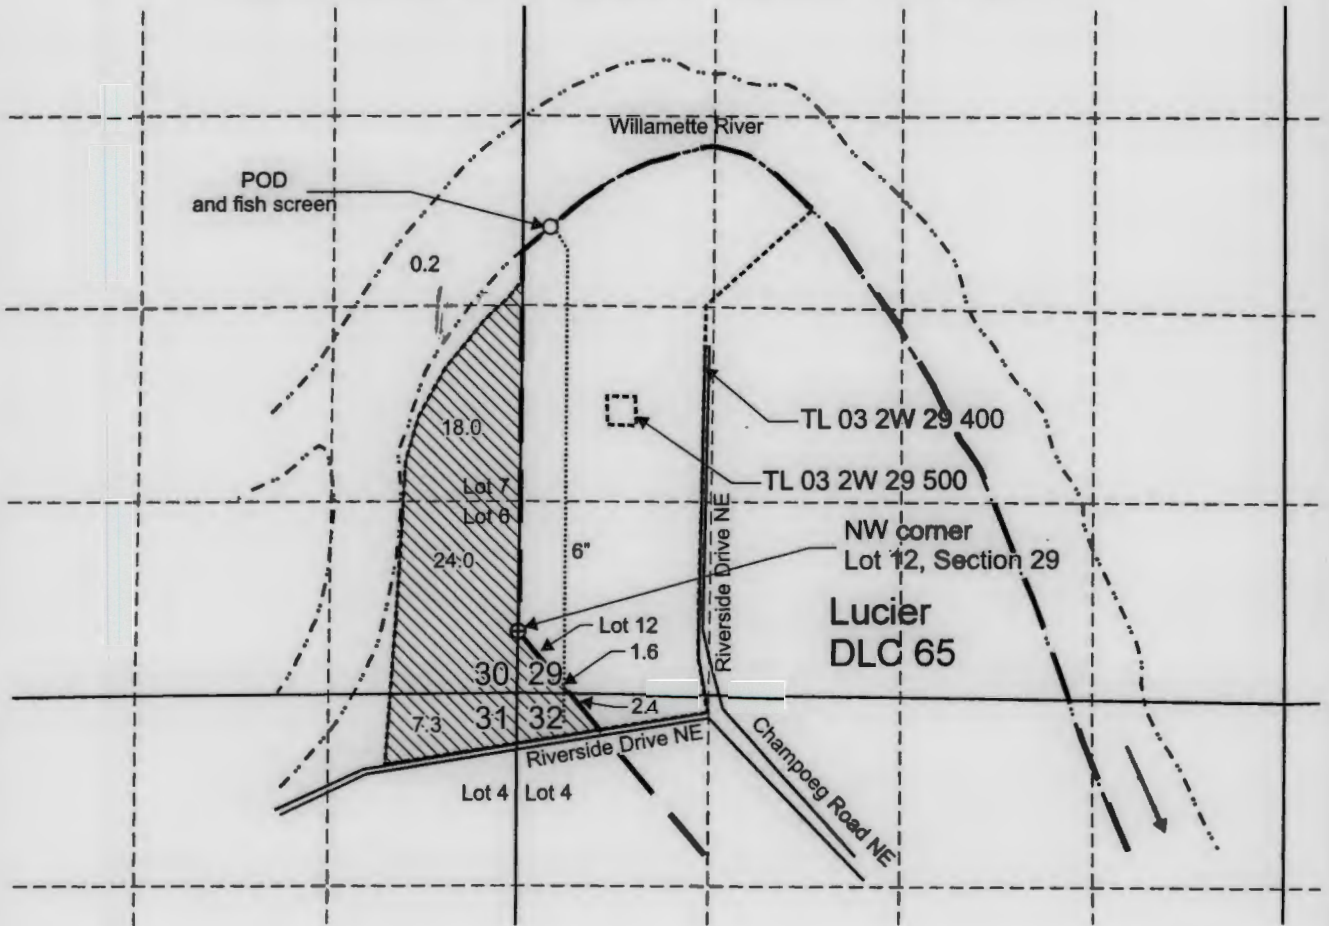


POD and fish screen are located 2,770 feet north and 230 feet east from the NW corner Lot 12, Section 29.

 Area (53.5 Acres) irrigated under T-11734.

 Tax lot boundary


 Donation Land Claim boundary

 Water main line

RECEIVED


APR 13 2017

OWRD

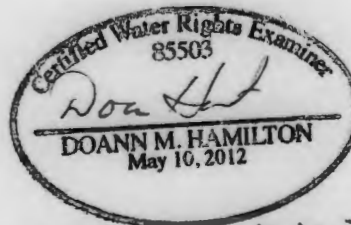

RECEIVED June 30 2017

Scale: 1" = 1,320'

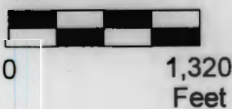

This map was prepared for the purpose of identifying the location of a water right only and is not intended to provide legal dimensions or location of property ownership lines.

Claim of Beneficial Use Map
T-11734

Pacific Hydro-Geology Inc.

KCK Partners LLC
T.3S. R.2W. Sec. 29 & 30, W.M.

03/2017