

MAP FOR

Claim of Beneficial Use

S28, T3N, R3W, Washington County

Appl S-53949, Permit S-41176



RECEIVED

JUL 08 2020

OWRD

1 IN = 400 FT
0 200 400

TAX LOT
BOUNDARY 3900

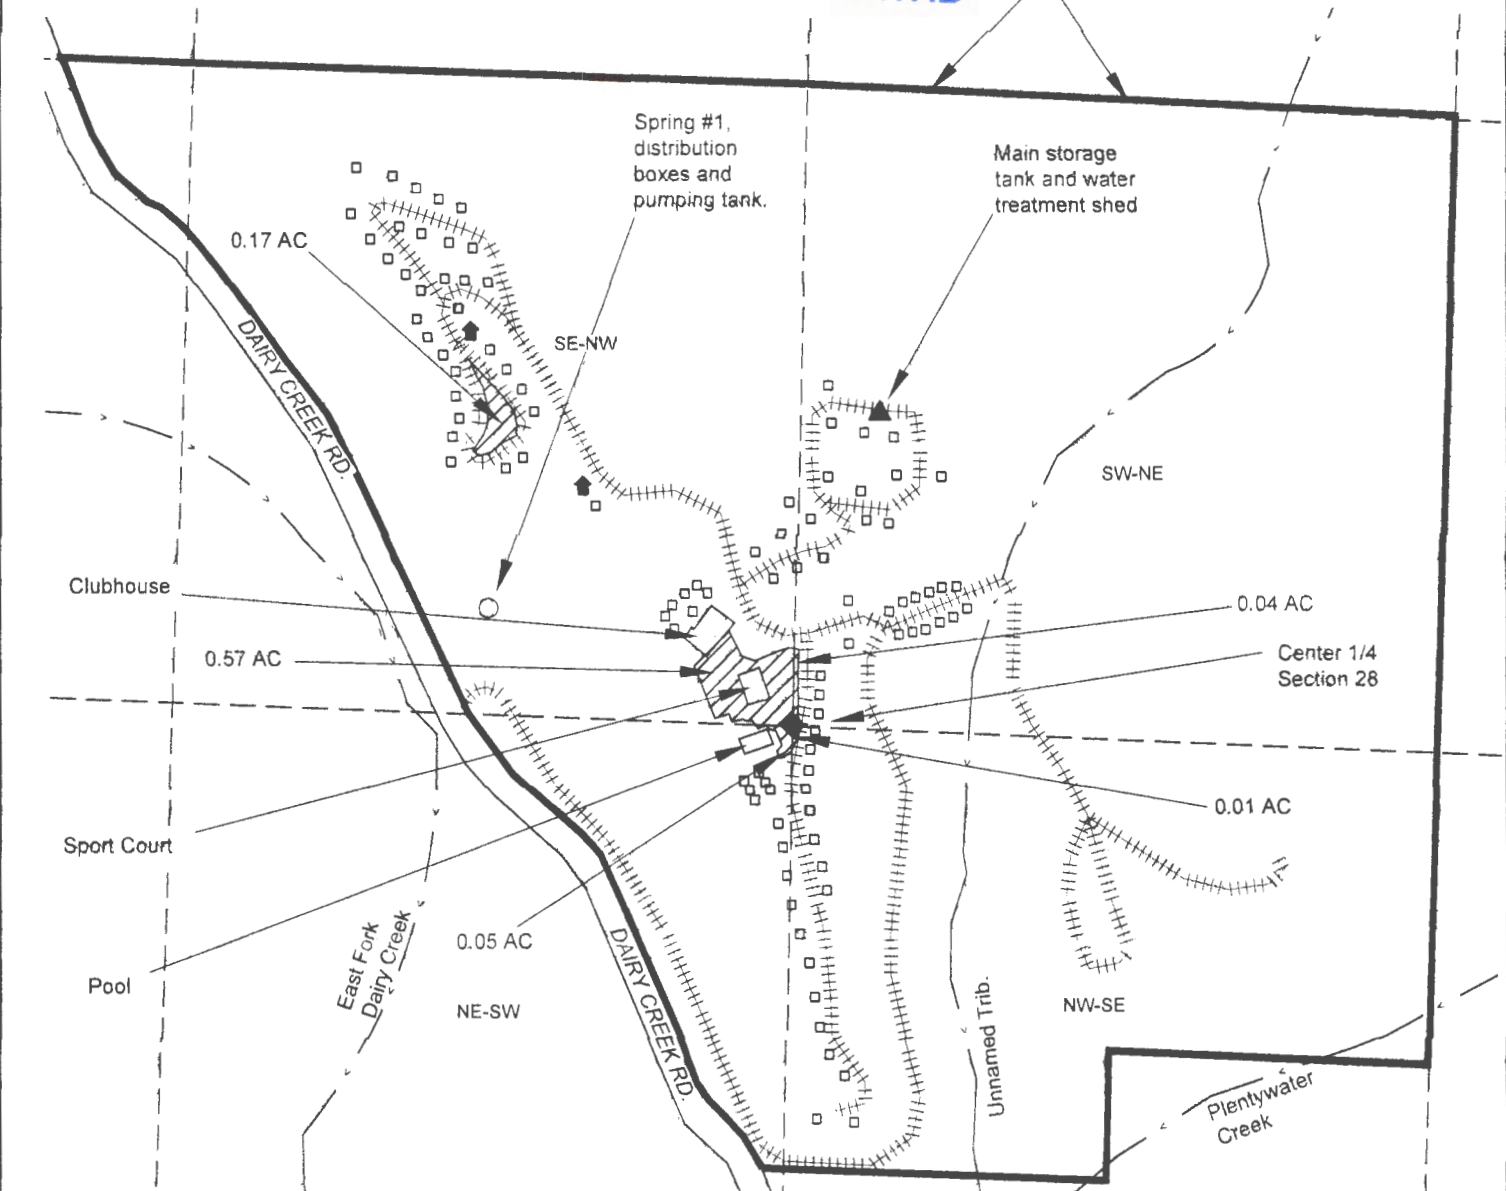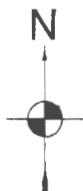

NOTES:

THIS MAP IS NOT INTENDED TO PROVIDE LEGAL DIMENSIONS OR LOCATIONS OF PROPERTY OWNERSHIP LINES.

-SECTION, QUARTER-QUARTER, ROAD, AND PROPERTY LINES ARE BASED ON THE TAX ASSESSOR MAP NAMED "3N 3 C".
STREAMS ARE FROM A USGS QUAD MAP.

-WATER CONVEYANCE LINES ARE ALL WITHIN THE PROPERTY, AND THE LOCATIONS ARE NOT KNOWN, SO THEREFORE THEY ARE NOT SHOWN.

-NO DONATION LAND CLAIMS EXIST IN THE AREA.

Spring #1 is 250' North and 630' West of the
Center 1/4 of Section S28.

LEGEND

- CAMPSITE/CABIN (APPROXIMATE LOCATION)
- ◆ RESIDENCE (APPROXIMATE LOCATION)
- ◆ CENTER 1/4 CORNER
- POINT OF DIVERSION
- STREAM OR SURFACE DRAINAGE
- TAX LOT LINE
- SECTION LINE
- - - QUARTER-QUARTER LINE
- + + + + + GRAVEL ROAD
- ▨ IRRIGATION

MAP BY:
**ASPEN RURAL LAND
CONSULTING**

ERIC URSTADT, PE, PLS
971-250-1520
Jun2020
MountaindaleSun2A

