


Twp 14 S, Rng 8 W, Sec 2, Q-Q NW SE

Taxlot #: 402


1" = 300'

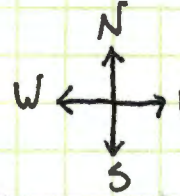

RECEIVED

APR 22 2019

CWRP

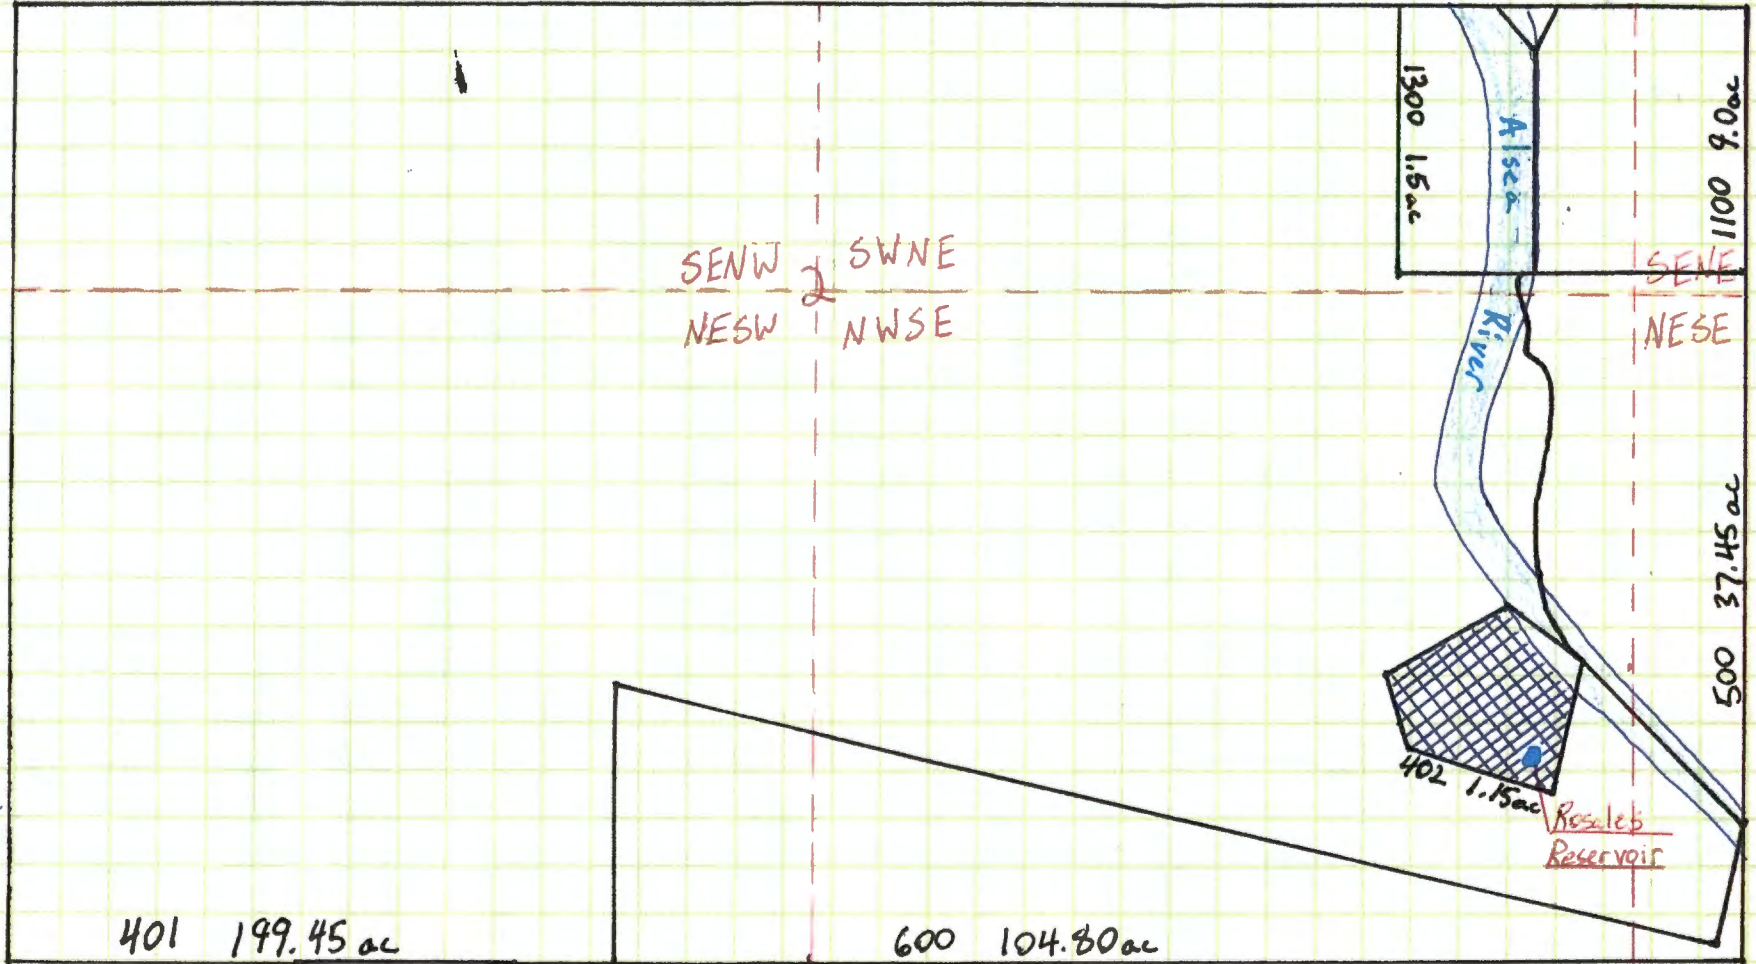

-Hatching indicating area of water use.

Surface water to be drawn from Rosales Reservoir (Permit R-15353). Rosales Reservoir located 826 feet South and 1,199 feet East from the center of Section 2. 1 acre of land located on taxlot 402 in Quarter/Quarter NW SE of Section 2 will be utilizing the surface water for nursery operations.