



Voluntary Cancellation - Portion of Certificate 24691 Bylund, Stephen & Belinda

1 inch = 400 feet

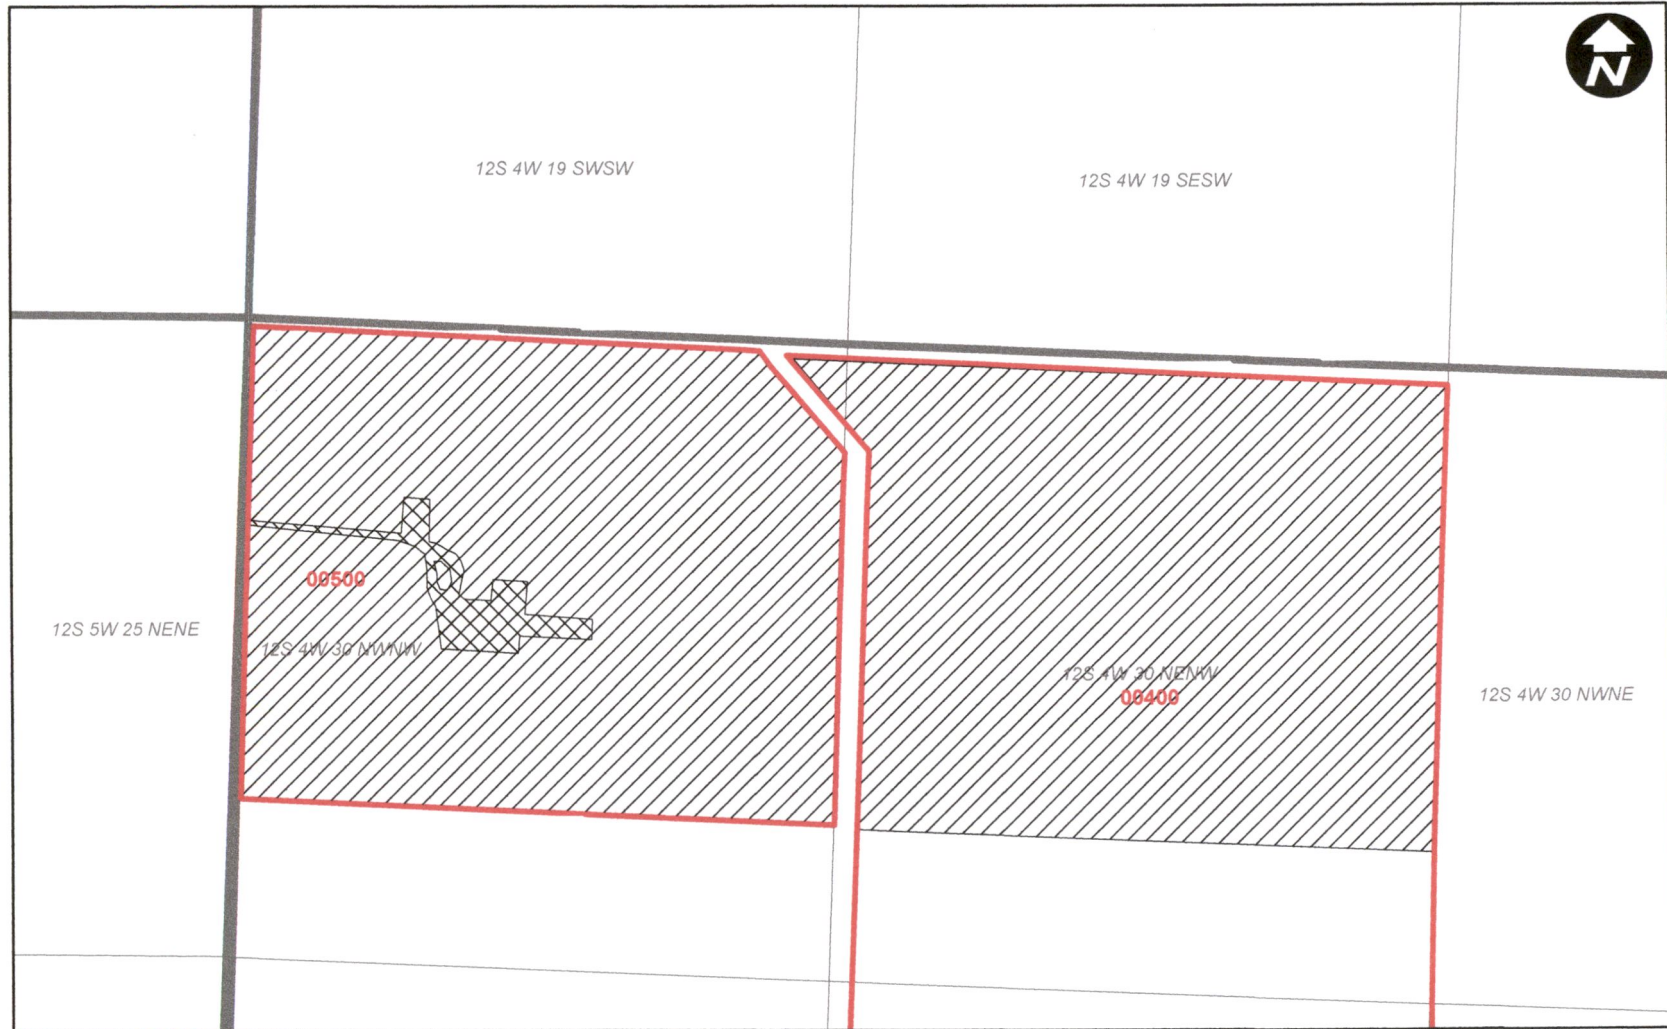

Legend

-  Cert. 24691 - 54.42 ac. Remaining
-  Cert. 24691 Voluntary Cancellation - 1.0 ac.
-  Tax Lot

RECEIVED

JUN 08 2020

OWRD

13461 -

RECEIVED

JUN 08 2020

OWRD

Ownership Update - Portion of Certificate 24691
Bylund, Stephen & Belinda

1 inch = 400 feet





Legend

-  Cert. 24691 Partial Ownership Update
-  Cert. 24691 No Change
-  Tax Lot

13461 -

Historic Change in Point of Appropriation
 Portion of Certificate 24691
 Bylund, Stephen & Belinda

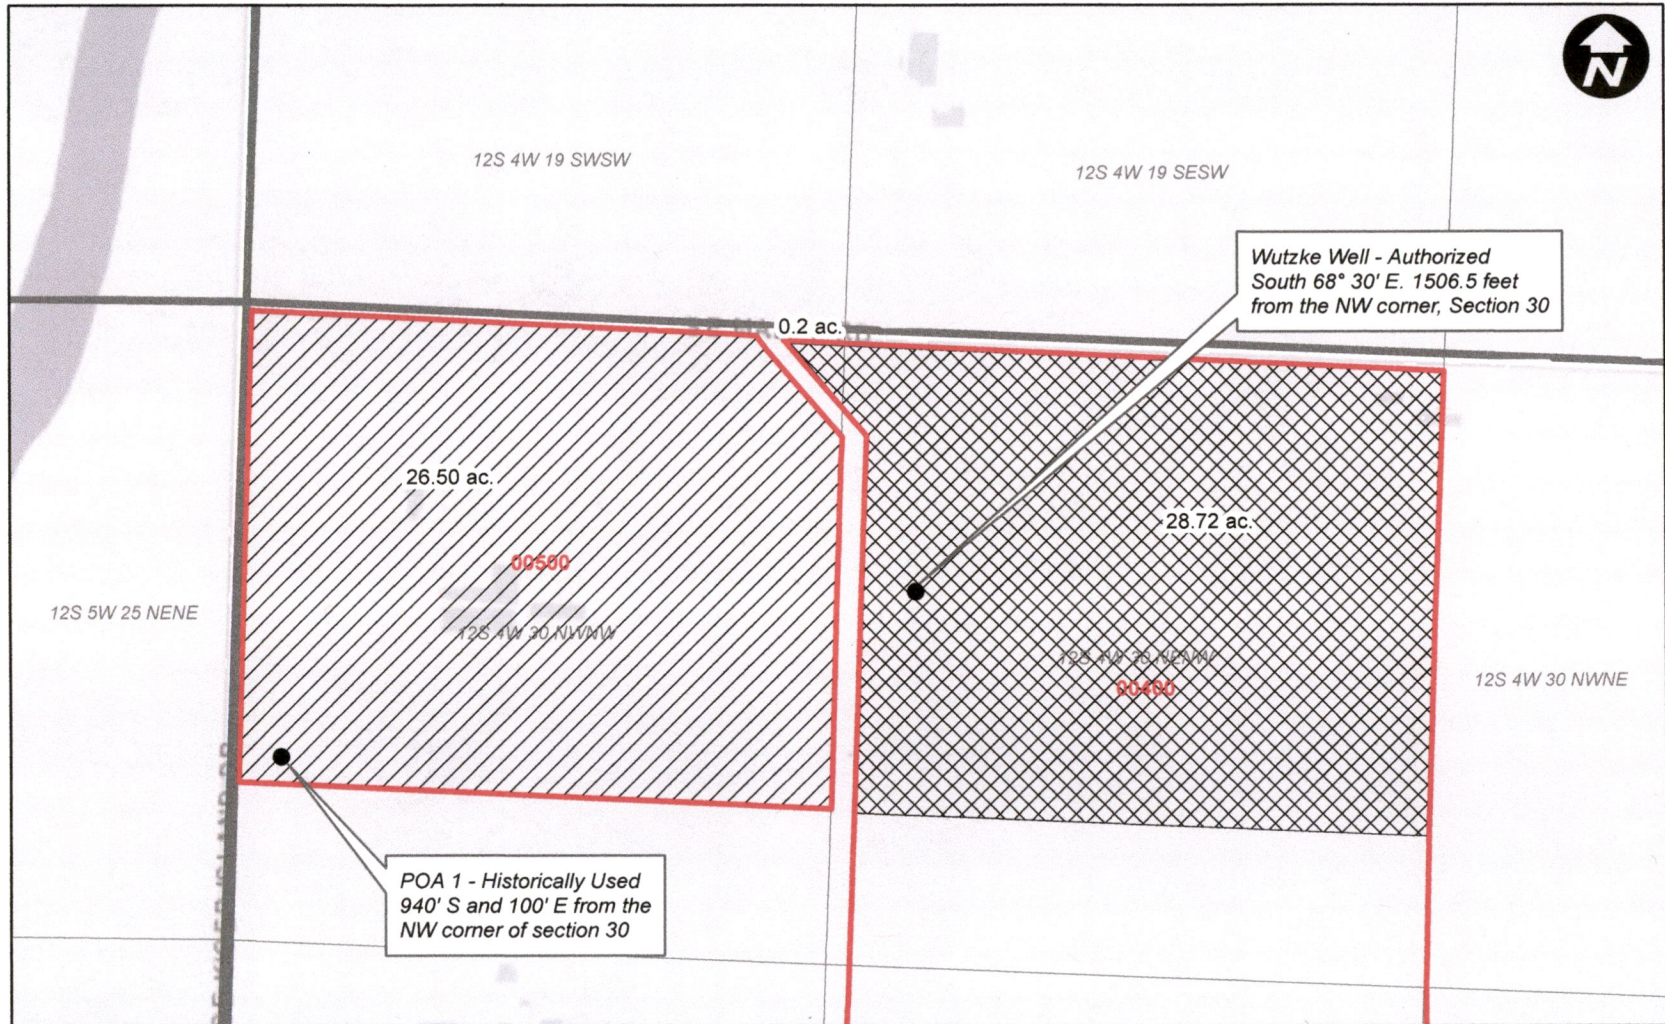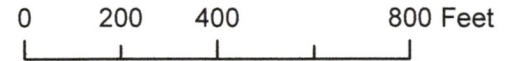

Legend

- Cert. 24691 Change POA
- Cert. 24691 No Change
- Tax Lot

RECEIVED

JUN 08 2020

OWRD

13461 -



Google Earth

Imagery Date: 7/26/2018 44°30'22.35" N 123°14'09.35" W elev 230 ft eye alt 4662 ft

RECEIVED

JUN 08 2020

OWRD

13461 -