


RECEIVED

DEC 17 2018

OWRD

SEC. 2, T.14S., R.30E., W.M.

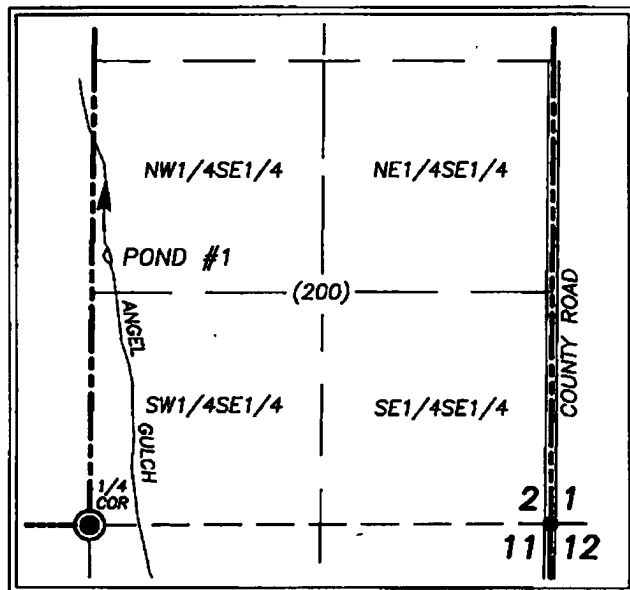

POND #1 Dam is 1590 ft. North & 100 ft. East of the S1/4 Sec. 2



SCALE: 1" = 1000'

RECEIVED BY OWRD

AUG 28 2017

APPLICATION MAP
for
Permit to Store Water
(Alternate Process)

SALEM, OR

In Name Of
RICHARD PAGE

Prepared By:
Michael C. Springer, PLS, CWRE
Benchmark Land Surveying
217 N. Canyon Blvd.
John Day, Oregon
(541) 575-1251
benchmarkls.com

Survey Conducted July 17, 2017


----- Tax Lot Line

() Tax Lot No.

● Found brass cap at S1/4 Cor.
Section 2, T.14S., R.30E., W.M.

DISCLAIMER: THIS MAP IS NOT INTENDED TO PROVIDE LEGAL
DIMENSIONS OR LOCATIONS OF PROPERTY BOUNDARY LINES.

R-98442

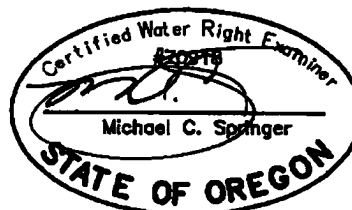

Expires 6/30/2018

RECEIVED


JAN 11 2019

OWRD

RECEIVED

DEC 17 2018

QWRD

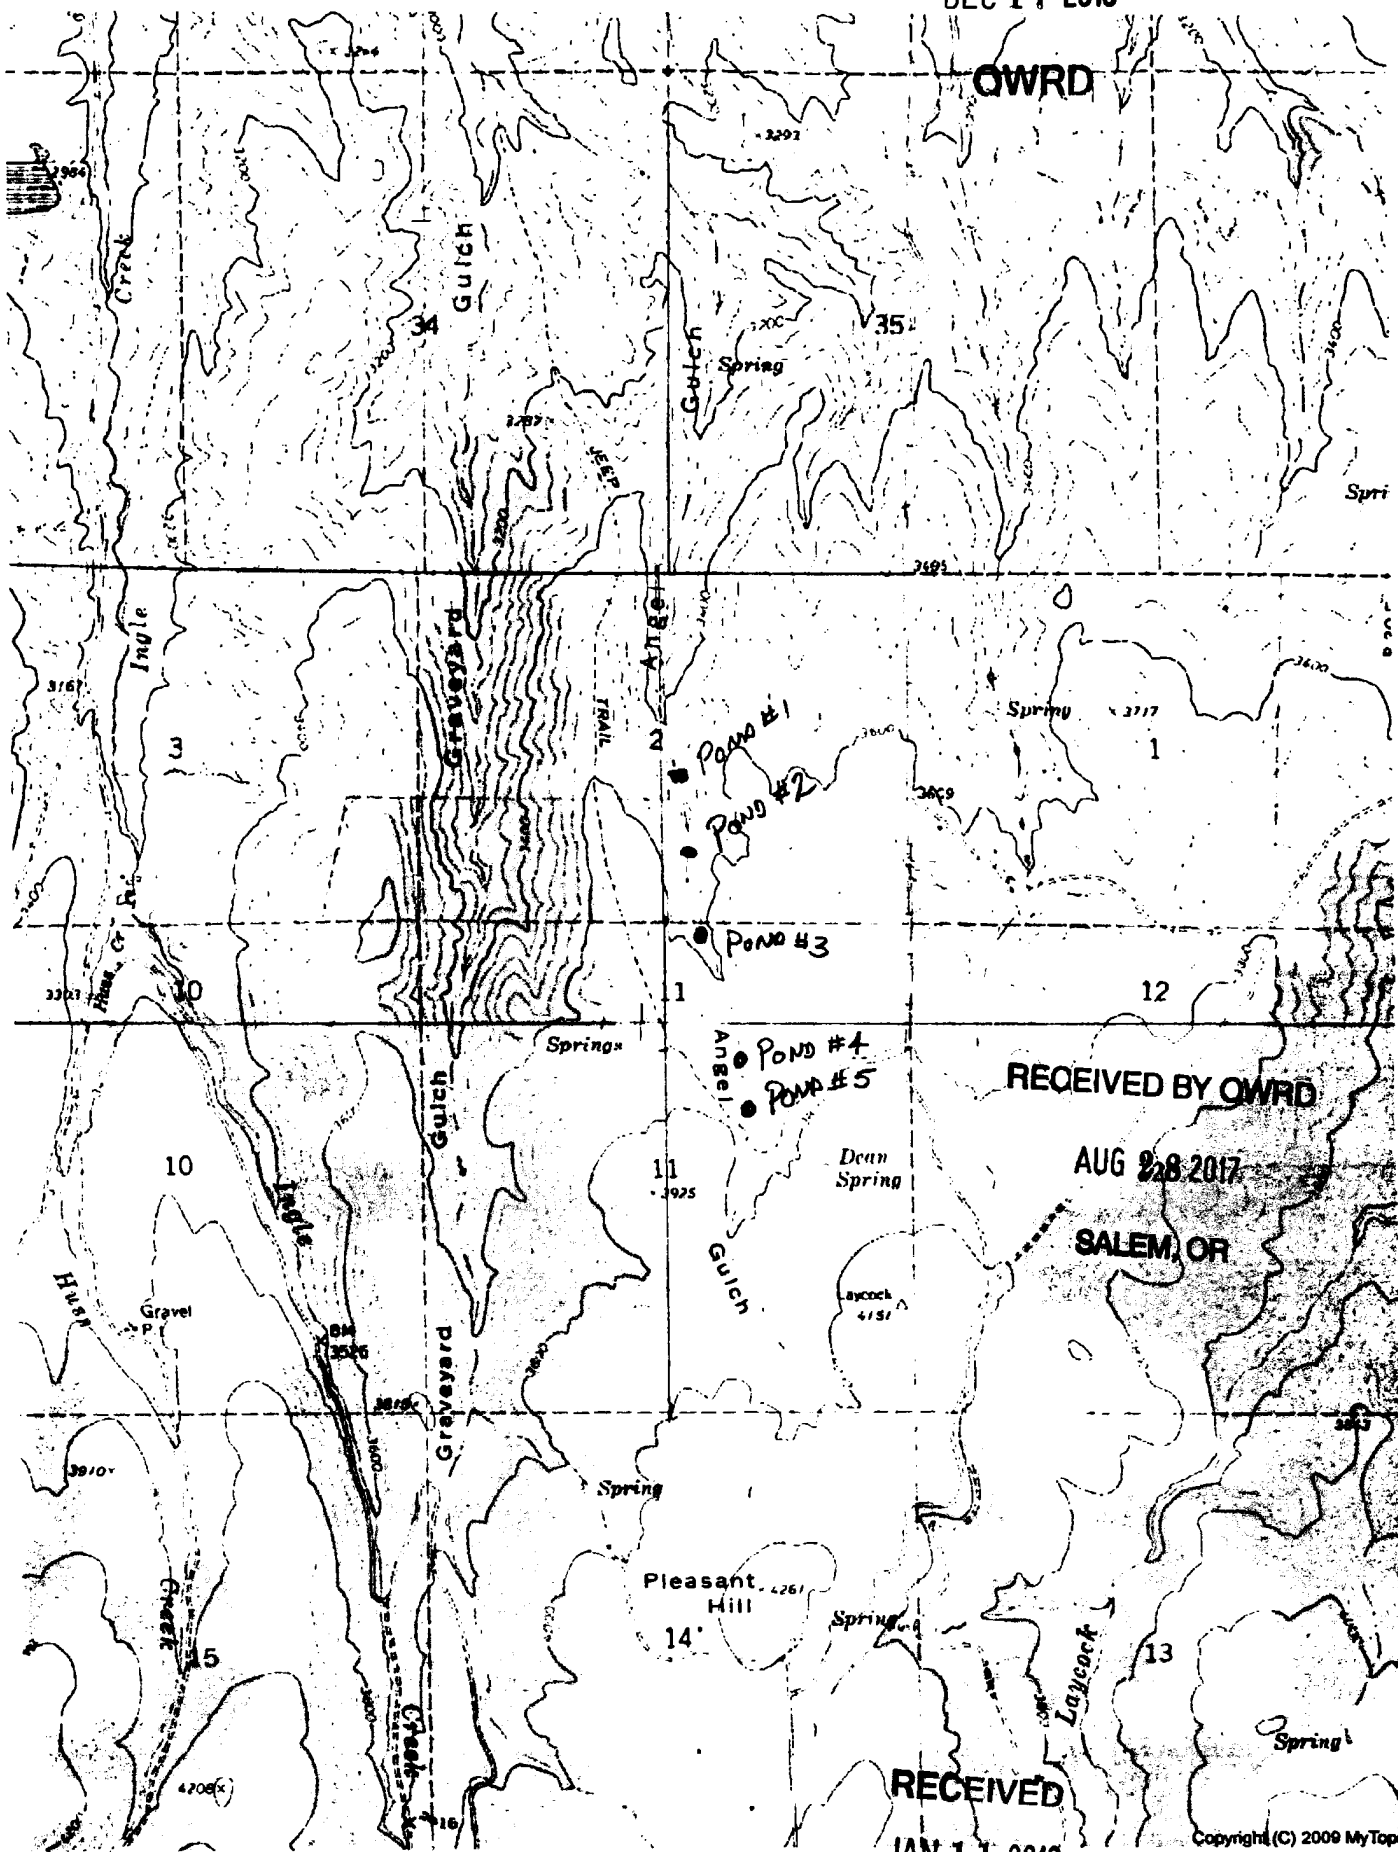

R-88449

RECEIVED
JAN 11 2019

QWRD